
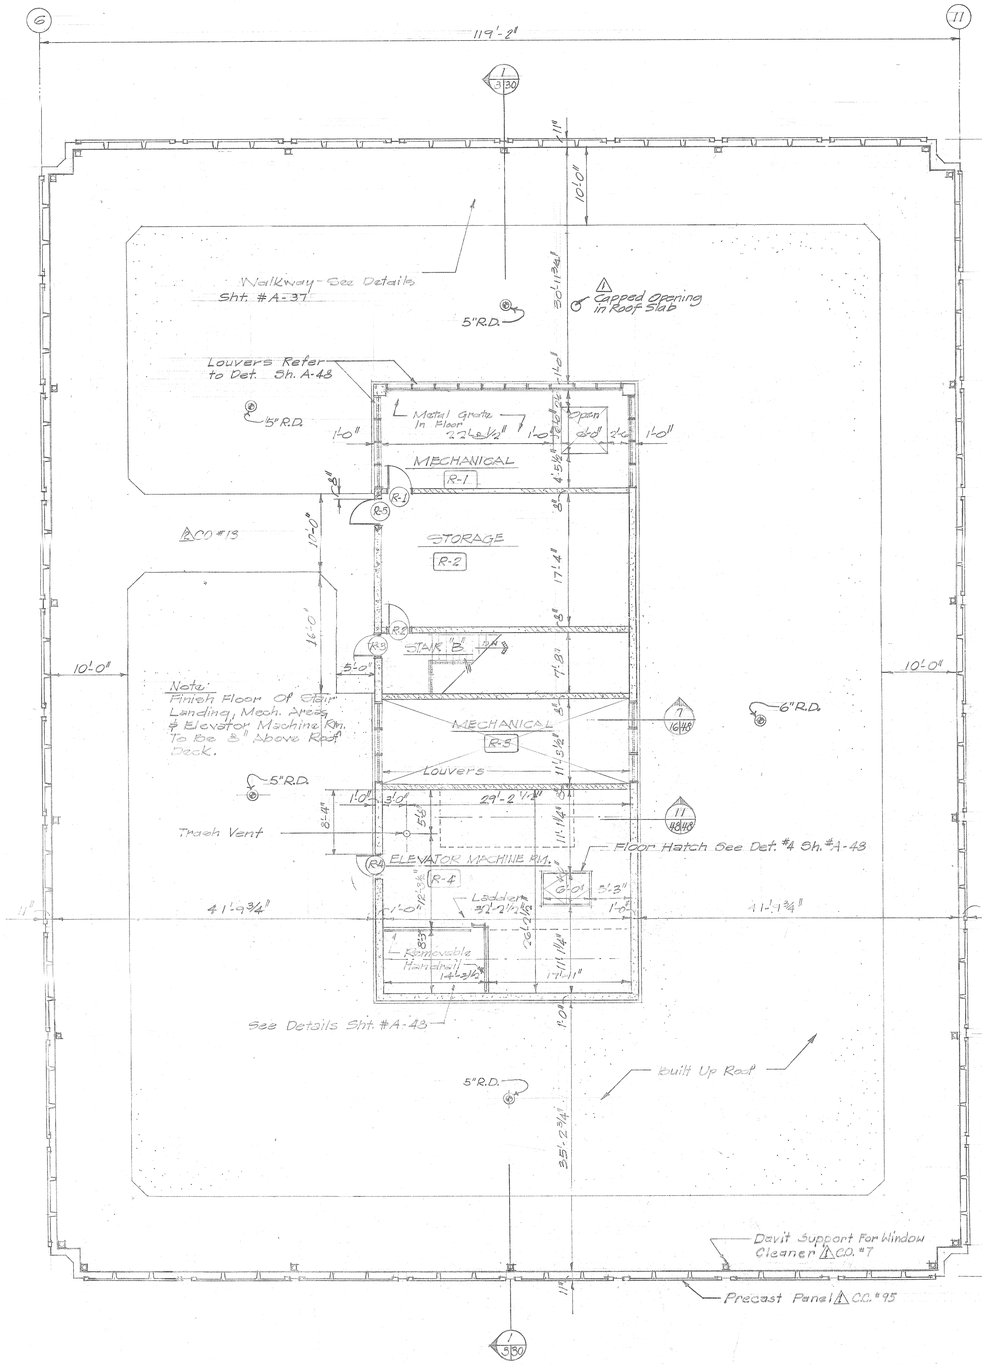


TOWER ROOF PLAN

Scale: 1/8" = 1'-0"

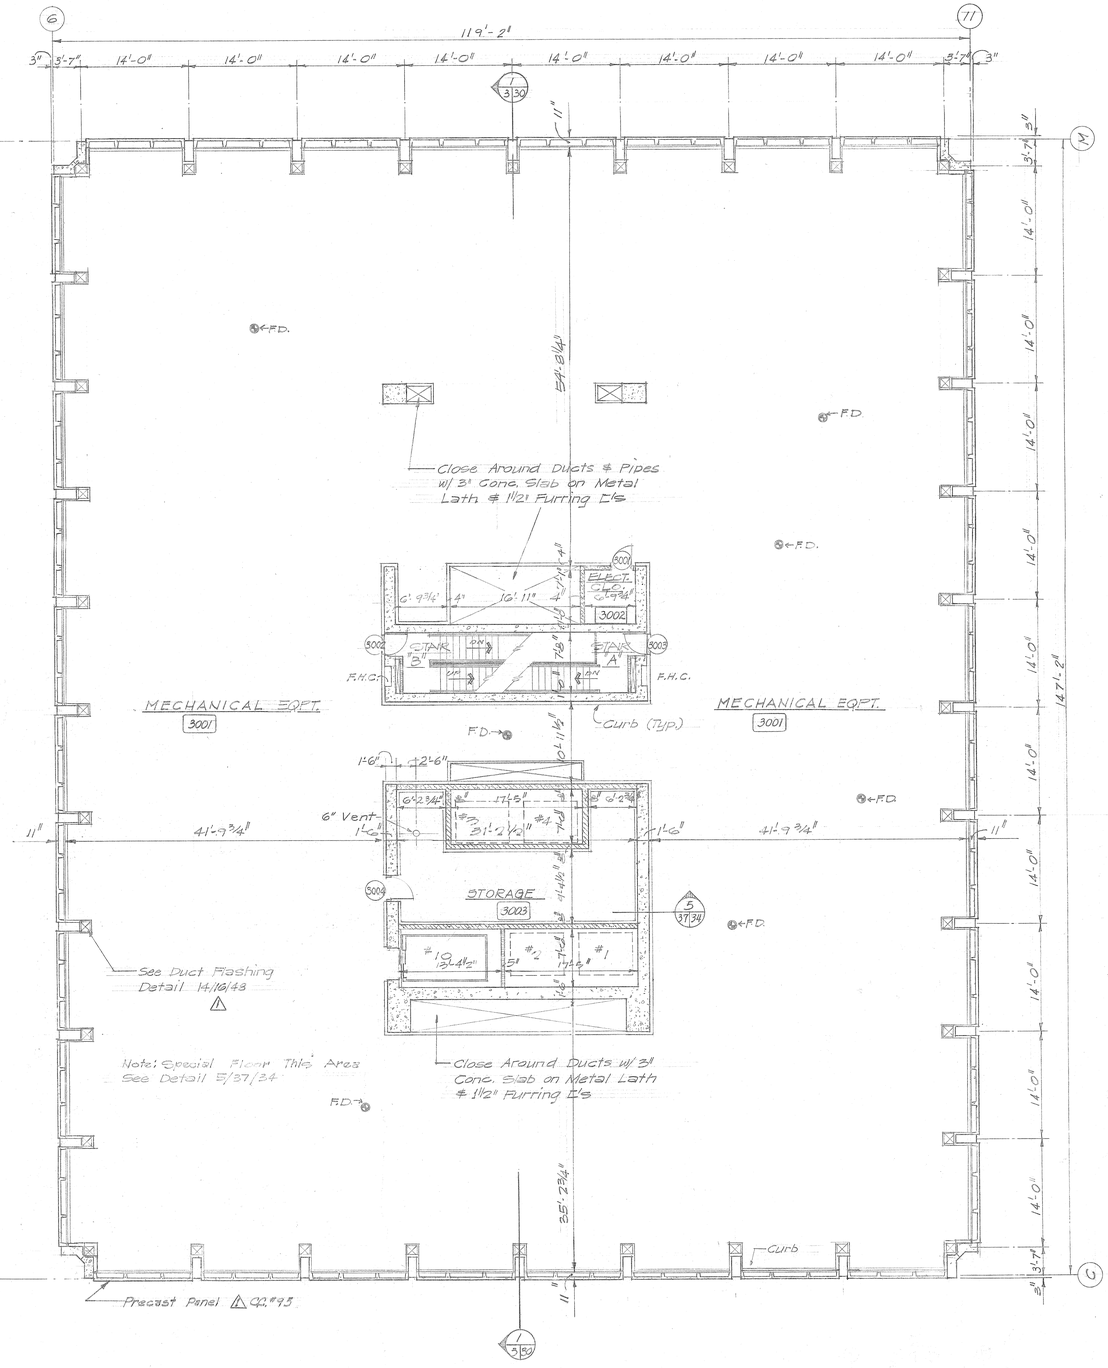

TOWER PLAN - 30TH FLOOR (MECHANICAL)

Scale: 1/8" = 1'-0"

FRANKFURT · SHORT · EMERY · McKINLEY **ARCHITECTS · ENGINEERS**

MEMBER AMERICAN INSTITUTE OF ARCHITECTS

MEMBER AMERICAN SOCIETY OF HEATING, REFRIGERATING AND AIR CONDITIONING ENGINEERS

REVISION	DESCRIPTION	DATE
1	As Built Conditions	1 Mar 74
2		
3		
4		
5		

KERR-McGEE CENTER
OKLAHOMA CITY, OKLAHOMA

ROOF AND 30TH FLOOR TOWER PLAN

COMM. NO. 56624
DATE 29 Sept 1969
SHEET NO. A-16

FINISH SCHEDULE


RM. NO.	ROOM NAME	FLOOR: CARPET (NIC)	FLOOR: CERAMIC TILE	FLOOR: VAT	FLOOR: CONCRETE	FLOOR: RUBBER TREADS	BASE: RUBBER	BASE: CERAMIC TILE	BASE: MOVE	WALLS: PLASTER - SMOOTH FIN.	WALLS: CERAMIC TILE	WALLS: PLASTER - SAND FIN.	WALLS: CONC. PAINT	WALLS: PLASTER PAINT	WALLS: VINYL WALL COVERING	WALLS: CONC. - EXP. - PAINT	WALLS: GYP. BD. - PAINT	CEILING MAT'L: ACOUST. TILE	CEILING MAT'L: EXPOSED STRUCT.	CEILING MAT'L: PLASTER - SMOOTH FIN.	CEILING MAT'L: CONC. PAINT	CEILING MAT'L: PLASTER - SAND FIN.	CEILING MAT'L: ACOUST. PLASTER	H.T.	REMARKS
	TYPICAL CORE																								Note: Rubber base used w/ Carpet (NIC) Shall be Straight type. See Finish Notes on Sht. A-18; A-19. 2 C.O.#37 Delete Painting of Plaster Surfaces in Rms... T-03 (4th - 29th Flrs)
T-01	E.L.EV. LOBBY	●																							
T-02	CUSTODIAN				●																				
T-03	ELECTRICAL CLOSET				●																				
T-04	MEN		●																						
T-05	WOMEN		●																						
T-06	LOUNGE	●																							
T-07	MOP ROOM																								
T-08	E.L.EV. LOBBY	●																							
T-09	MAIL ROOM	●																							
T-10	TYP. OFFICE SPACE				●																				
	STAIR - "A"			●		●																			
	STAIR - "B"			●		●																			

Omitted C.O. #61


8'-0" | Add. "1 Pg. 3 | " " C.O. #14, " " #91

8'-6" | Add. "1 Pg. 3 C.O. #18 (Except 5th Flr.) | " " C.O. #42 (Except 11th Flr.) | Appendix Item 9.4


* Add. "1 Pg. 3 T-01, 03 8'-0" High Smooth Plaster Clg. Over Water Closet.

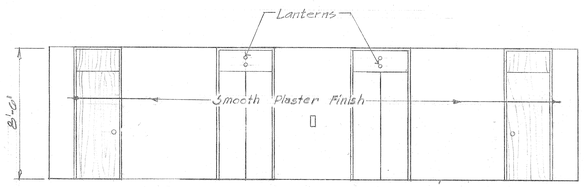

SOUTH ELEV. R.M. # T-01
C.O. #40, 52

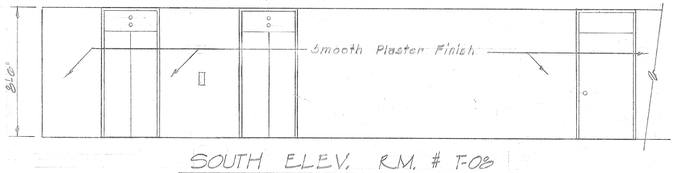


SOUTH ELEV. R.M. # T-03
C.O. #40, 52

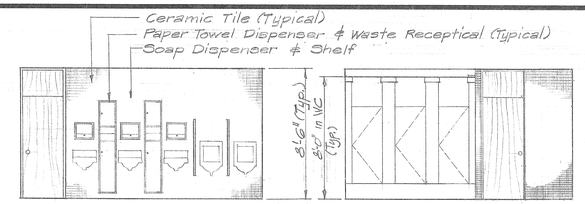


WEST ELEV. RM. # T-04

SOUTH ELEV. RM. # T-04

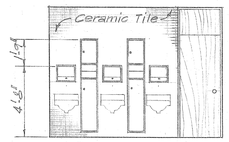


EAST ELEV. RM. # T-05

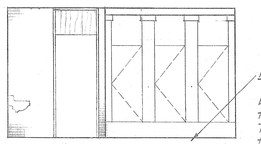


SOUTH ELEV. RM. # T-05


Note: Waterproof Membrane Between the Grout & the Structure at all Toilets Unless Noted to the Contrary.

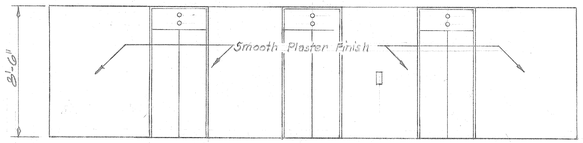


NORTH ELEV. R.M. # T-01
C.O. #40, 52

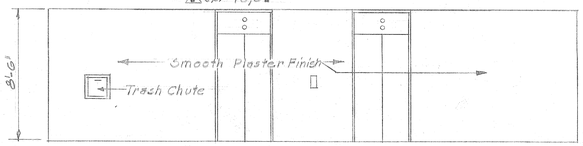


NORTH ELEV. R.M. # T-03
C.O. #40, 52

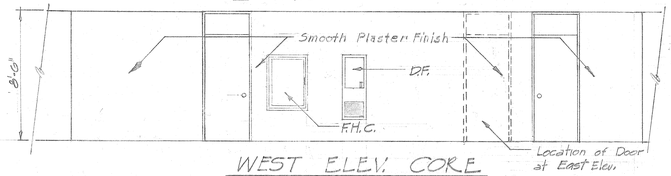

WEST ELEV. CORE
East Elev. Similar.
C.O. #40, 52
Location of Door at East Elev.

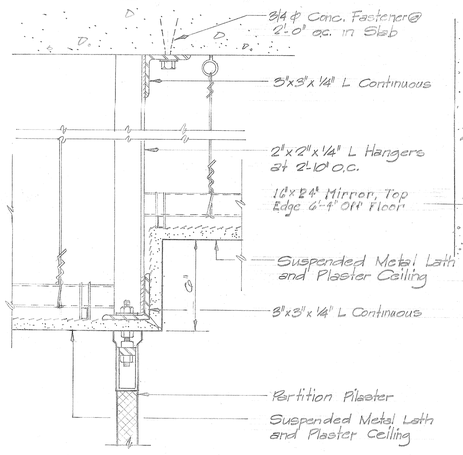


TYPICAL SUSPENDED TOILET PARTITION
Scale: 3" = 1'-0"

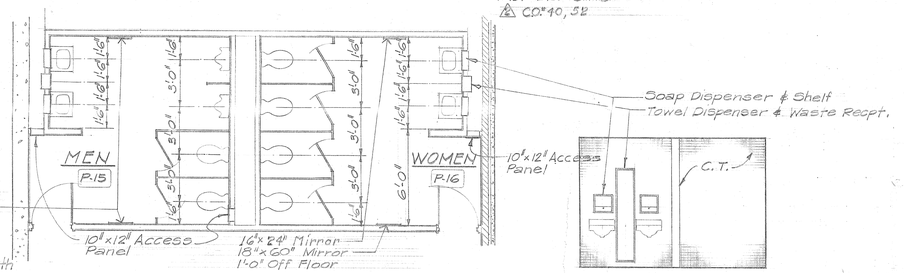


ENLARGED PLAN OF RM'S. P-15 & P-16
Scale: 1/4" = 1'-0"
C.O. #112 C.O. #108


EAST WALL P-16

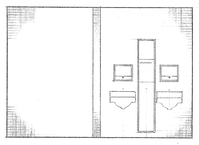


WEST WALL P-15

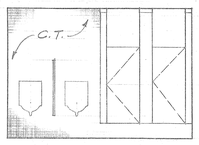

EAST WALL P-15

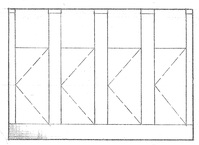

WEST WALL P-16

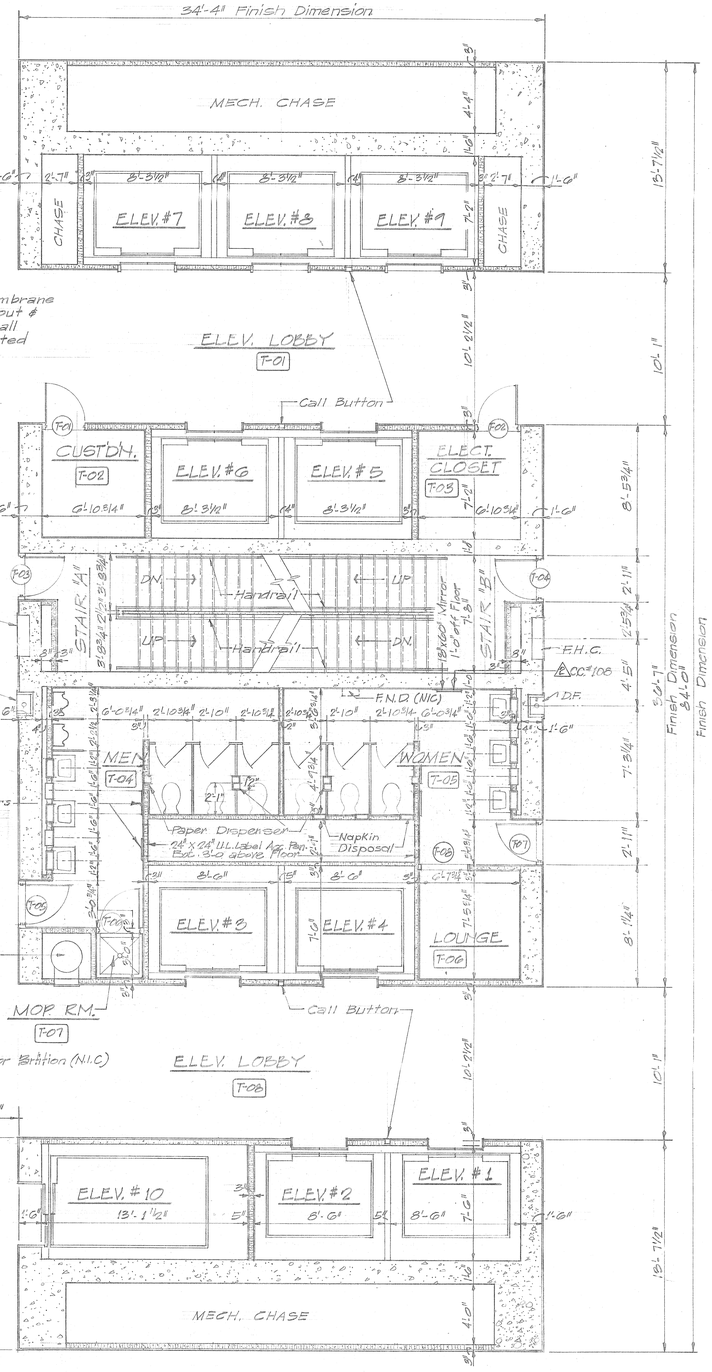

TYP. OFFICE SPACE
T-11

TYPICAL CORE PLAN
Scale: 1/4" = 1'-0"

FRANKFURT · SHORT · EMERY · McKINLEY ARCHITECTS · ENGINEERS

MEMBER AMERICAN INSTITUTE OF ARCHITECTS

MEMBER AMERICAN SOCIETY OF HEATING, REFRIGERATING AND AIR CONDITIONING ENGINEERS

REVISION	DESCRIPTION	DATE
1	Added Addenda & Appendix Items.	1 Mar. 74
2	As Built Conditions	1 Mar. 74
3		
4		
5		
6		

KERR-McGEE CENTER
OKLAHOMA CITY, OKLAHOMA

TYPICAL CORE PLAN TOWER

COMM. NO. 9666'24
DATE 19 Sept 1969
SHEET NO. A-17


ROOM FINISH SCHEDULE

RM. NO.	ROOM NAME	FLOOR: CARPET N.I.C.	FLOOR: CERAMIC TILE	FLOOR: VAT	FLOOR: CONCRETE	FLOOR: GRANITE	FLOOR: RUBBER TREADS	FLOOR: BRICK PAVING	BASE: RUBBER	BASE: CERAMIC TILE	BASE: NONE	BASE: GRANITE	WALLS: PLASTER BRK. CT. ONLY	WALLS: PLASTER - SMOOTH FIN.	WALLS: CERAMIC TILE	WALLS: PLASTER - SAND FIN.	WALLS: CONC.	WALLS: CARPET	WALLS: GRANITE	WALLS: VINYL WALL COVERING	WALLS: CONC. BLOCK	WALLS: WOOD PANELING	WALLS: SANDBLASTED CONC.	CEILING MAT'L: ACOUST. TILE	CEILING MAT'L: EXPOSED STRUCT.	CEILING MAT'L: PLASTER - SMOOTH FIN.	CEILING MAT'L: WOOD CEILING	CEILING MAT'L: PLASTER - SAND FIN.	CEILING MAT'L: LUMINOUS GRID	CEILING MAT'L: ACOUST. PLASTER	HT.	REMARKS
																															NOTE: All Conc. Walls in Basement, Lower Basement, & Upper Basement Levels Shall Have Rubbed Finish in Lieu Of Sandblast.
	LOWER BASEMENT																														
LB-1	TRANSFORMER VAULT	●							●					●											●							
LB-2	ELECT. SERVICE VAULT	●							●					●											●							Conc. Hardening Flr. Fin.
LB-3	STORAGE VAULT	●							●					●											●							" " "
LB-4	STORAGE	●							●					●											●							" " " "
LB-5	SPKLR. EQUIPT. ROOM	●							●					●											●							" " "
	STAIR "E"	●					●		●					○											○							See Section - Sht. A-40
LB-6	STORAGE	●							●					●							●				●							Conc. Hardening Flr. Fin.
~~LB-7~~	~~TAPE ROOM (Delete △ CO "10)~~	~~●~~							~~●~~					~~●~~							~~●~~				~~●~~							~~" " " " "~~
LB-8	STORAGE	●							●					●							●				●							" " " "
LB-9	CORRIDOR	●							●					●							○				●							" " " "
LB-10	M.E. ROOM	●							●					●											●							
LB-11	ELEV. MACHINE RM.	●							●					●											●							
~~LB-12~~	~~M.G. ROOM (Delete △ CO "10)~~	~~●~~							~~●~~					~~●~~							~~●~~				~~●~~							
	BASEMENT																														
B-2	MECH. EQUIPT.	●							●					●							●				●							" " " "
B-3	CORRIDOR	●							●					●							□				●					9'-0"	△2 C.O. #48
B-4	DRY STORAGE	●							●					●							□				●							
B-5	RECEIVING	●							●					●							□				●					9'-0"	△2 C.O. #48
B-6	CORRIDOR	●							●					●							□				●							Concrete Hardening Flr. Fin.
B-7	DOCK	●							●					●							□				●							" " " "
B-8	TRASH	●							●					●							□				●							△ CO. "48
B-9	WOMEN												●	●											●							
B-10	MEN												●	●											●							
B-11	VALVE ROOM	●							●					●											●							
B-12	LOCKER ROOM	●							●					●											●					8'-6½"	△ Add. "2 Pg. 6
B-13	LAUNDRY	●							●					●											●					8'-6½"	△ " "
B-14	ELECT. CLOSET								●				△1	△1											△2					8'-6"	△2 C.O. #37, △1 Add. #1, Pg. 3
B-15	CUSTODIAN	●							●				△1	△1											●					8'-6"	△1 Add #1 Pg 6
B-16	ELEV. LOBBY	●							●					●											△2					8'-6"	△ CO "52, 53
B-17	REFUSE	●							●					●											●					—	Conc. Hardening Flr. Fin.
B-18	MEN	●							●					●											●					8'-6"	
B-19	STORAGE								●					●											●					8'-6"	
B-20	CORRIDOR	●							●					●											△2					8'-6"	△ CO "52, 53
B-21	DOCK	●							●					●											●					—	Conc. Hardening Flr. Fin.
B-22	ELEV. LOBBY	●							●					●											△2					8'-6"	△2 C.O. #52, 53
B-23	STORAGE	●							●					●											●					—	Concrete Hardening Flr. Fin.
B-24	DOCK	●							●					●											●							
B-25	STORAGE	●							●					●											●					—	" " " "
B-26	MECHANICAL	●							●					●											●							
B-27	RAMP	●							●					●											●							
	STAIR "G"	●							●					□											●							
	STAIR "A"	●							●					○											●					—	See Section - Shts. A-38,39
	STAIR "B"	●							●					○											●					—	" " " "
	STAIR "F"	●							●					●											●					—	See Section - Sht. A-39
	STAIR "D"	●							●					○											●					—	See Section - Sht. A-40
	UPPER BASEMENT																														
UB-1	MECH. ROOM	●							●					●											●					—	Conc. Hardening Flr. Fin.
UB-2	COMPUTER EXPANSION	●							●					●											●					—	
	PLAZA																														
P-1	VESTIBULE		●							●				●											●					9'-6"	△ Add. "2 Pg. 6
P-2	DINING	●								●				●											●					9'-6"	△ " "
P-3	DISHWASHING		●							●				●											●					9'-6"	△ " "
P-4	KITCHEN		●							●				●											●					9'-6"	△ " "
P-5	CORRIDOR	●								●				●											●					9'-6"	△ " "
P-6	OFFICE	●								●				●											●					9'-6"	△ " "
P-7	DINING		●							●				●											●					9'-6"	△ " "
P-8	DINING		●							●				●											●					9'-6"	△ " "
P-9	CORRIDOR	●								●				●											●					9'-6"	△ " "
P-10	PRIVATE PANTRY		●							●				●											●					9'-6"	△ " "
P-11	PRIVATE DINING		●							●				●											●					9'-6"	△ " "
~~P-12~~	~~DINING (Delete)~~	~~●~~								~~●~~				~~●~~											~~●~~					~~9'-6"~~	~~" " " " "~~
P-13	LOUNGE	●								●				●											●					9'-6"	△ Add. "2 Pg. 6
P-14	CORRIDOR	●								●				●											●					9'-6"	△ " "
P-15	MEN		●							●				●											●					8'-6"	
P-16	WOMEN		●							●				●											●					8'-6"	
P-17	SHOP AREA "A"		●							●				●											●					—	
P-18	ELEV. LOBBY		●							●				●											●					12'-0½"	
P-19	STORAGE		●							●				●											●					8'-6"	
P-20	ELECT. CLOSET		●							●				●											△2					—	△2 CO "37
P-21	WEST LOBBY		●							●				●											●					24'-1¾"	
P-22	TOILET		●							●				●											●					8'-6"	
P-23	CONTROL CENTER		●							●				●											△1					8'-6½"	△1 See Sketch - A2, "E", C.O. "3
P-24	STORAGE		●							●				●											●					8'-6"	△1 Add. "2 Pg. 6
P-25	EAST LOBBY		●							●				●											●					12'-0"	△2 C.O. #81
P-26	ELEV. LOBBY		●							●				●											●					24'-1½"	
P-27	WOMEN'S LOUNGE	●								●				●											●					12'-0½"	
																														8'-0"	△1 Add. "2 Pg. 6, △2 C.O. #81


RM. NO.	ROOM NAME	FLOOR: CARPET N.I.C.	FLOOR: CERAMIC TILE	FLOOR: VAT	FLOOR: CONCRETE	FLOOR: GRANITE	FLOOR: RUBBER TREADS	FLOOR: BRICK PAVING	BASE: RUBBER	BASE: CERAMIC TILE	BASE: NONE	BASE: GRANITE	WALLS: PLASTER BRK. CT. ONLY	WALLS: PLASTER - SMOOTH FIN.	WALLS: CERAMIC TILE	WALLS: PLASTER - SAND FIN.	WALLS: CONC.	WALLS: CARPET	WALLS: GRANITE	WALLS: VINYL WALL COVERING	WALLS: CONC. BLOCK	WALLS: WOOD PANELING	WALLS: SANDBLASTED CONC.	CEILING MAT'L: ACOUST. TILE	CEILING MAT'L: EXPOSED STRUCT.	CEILING MAT'L: PLASTER - SMOOTH FIN.	CEILING MAT'L: WOOD CEILING	CEILING MAT'L: PLASTER - SAND FIN.	CEILING MAT'L: LUMINOUS GRID	CEILING MAT'L: ACOUST. PLASTER	HT.	REMARKS
																															△ CO "37 Delete Painting of Plaster Surfaces in Rms. B-14, P-20, 207, 304, ..., 3004.
	PLAZA																														
P-28	WOMEN'S TOILET		●							●				●											●					8'-0"	
P-29	STORAGE		●							●				●											△2					8'-0"	△ C.O. #14
P-30	LOBBY				●					●				●											△1					9'-3"	△1 Add. "1 Pg. 3 / 12"x12"x 3/4"
P-31	COATS	●		●						●			△2												△2					9'-3"	△ CO. "103, △2 C.O. "61
P-32	ELECT. CLOSET									●			△1											●						8'-0"	" " "
P-33	PROJECTION ROOM									●														△2						8'-3"	△ CO. "103
P-34	MEN									●														●						8'-0"	
P-35	AUDITORIUM	●		●						●														△2	CO "14						Hgt. Varies - See Sht. A-47
P-36	STAGE				HARDWOOD					HARDWOOD														△2	CO "14						Hgt. Varies - See Sht. A-47
P-37	STORAGE			●						●				●											●						—	
P-38	MEZZANINE	●		●						●				●											●						—	
P-39	SHOP AREA "C"	●		●						●				●											●						—	
P-40	MECHANICAL			●						●				●											●						—	Conc. Hardening Flr. Fin.
P-41	SHOP "B"			●						●				●											●						—	
P-42	SHOP "B"			●						●				●											●						—	
P-43	SHOP AREA "B"			●						●				●											●						—	
P-44	MEN												●	●											●						—	
P-45	WOMEN												●	●											●						—	
P-46	MEN			●						●				●											●					6'-7¾"	△2
P-47	WOMEN			●						●				●											●					6'-7¾"	△2
P-48	STORAGE			●						●				●											△2					8'-6"	△ CO "14
	2ND FLOOR																														
201	MECH.			●						●				●											●					—	Conc. Hardening Flr. Fin.
202	MECH.			●						●				●											●					—	" " " "
203	MECH.			●						●				●											●					—	" " " "
204	ELEV. LOBBY	△1		●						●				●											●					8'-6½"	△ Appendix Item 9.7
205	MEZZANINE	△1		●						●				●											●					8'-6½"	△ " " " "
206	STORAGE			●						●				●											△2					8'-6"	△ Add. #1 Pg. 3 △ CO. "1
207	ELECT.			●						●				●											△2					—	△ C.O. #14, 37
208	MEZZANINE	△1		●						●				●											●					8'-6½"	△ Appendix Item 9.7
209	MEN												●	●											●					8'-6"	
210	STORAGE			●						●				●											●					8'-6"	△ C.O. "61
211	WOMEN'S TOILET												●	●											●					8'-6"	
212	CUSTODIAN			●						●				●											●					8'-6"	
213	STORAGE			●						●				●											●					8'-5"	△ C.C. #94
214	ELEV. LOBBY	△1		●						●				●											●					8'-6"	△ C.O. "61
215	MECH.			●						●				●											●					8'-6½"	△ Appendix Item 9.7
216	MECH.			●						●				●											●					8'-6"	
217	MECH.			●						●				●											●					8'-6"	
218	STORAGE			●						●				●											●					8'-6"	
	3RD FLOOR																														
301	ELEV. LOBBY			●						●				●											●					8'-6"	
302	MECH. EQUIPT.			●						●				●											●					8'-6"	
303	CUSTODIAN			●						●				●											●					8'-6"	
304	ELECT.			●						●				●											△2					—	△ CO "37
305	MECH. EQUIPT.			●						●				●											●						—	
306	STORAGE			●						●				●											●						—	
307	MOP ROOM			●						●				●											●						—	
308	CORRIDOR			●						●				●											●						—	
	14TH-17TH FLRS.	SEE TYPICAL FLOOR FINISH SCHEDULE; SHEET #A-17																													
	18TH FLOOR	REFER TO TYPICAL CORE PLAN, SHEET #A-17																													
~~1801~~	~~Telephone Equipt. (Delete △ CO "1)~~	~~●~~							~~●~~					~~●~~											~~●~~							
	19TH FLOOR	REFER TO TYPICAL CORE PLAN, SHEET #A-17																													
1901	ELEV. MACHINE ROOM	●							●					●											●						—	Conc. Hardening Flr. Fin.
	20TH-27TH FLR.	SEE TYPICAL FLOOR FINISH SCHEDULE; SHEET #A-17																													
	28TH-29TH FLR.	SEE TYPICAL FLOOR FINISH SCHEDULE; SHEET #A-17																													
	30TH FLOOR																														
3001	MECH. EQUIPT.			●						●				●											●						—	" " " "
3002	ELECT. CLOSET			●						●				●											△2					8'-6"	△ C.O. #37
3003	STORAGE			●						●				●											●						—	
	TOWER ROOF																														
R-1	MECH.			●						●				●											●						—	Conc. Hardening Flr. Fin.
R-2	STORAGE			●						●				●											●						—	" " " "
R-3	MECH.			●						●				●											●						—	" " " "
R-4	ELEV MACHINE ROOM			●						●				●											●						—	" " " "

GENERAL NOTES


1) ○ Symbol Indicates Painted Concrete or Concrete Block.
2) □ Symbol Indicates Descaglaze Paint Finish △ Add. "2 Pg. 4
3) Ceilings For the Following Rooms Are Not in this Contract: Computer Expansion, Restaurant, Shop Areas "A", "B", & "C".
4) Floor Carpeting is Not in This Contract. Carpeting On Walls Where Shown is in This Contract.
5) All Metal Stud Partitions Shall Extend To The Bottom Of Structural Slab Above.
6) New Work in Existing Buildings Shall Be Finished To Match Existing Work.
7) Parking Stall Markings Shall Be Spaced As Indicated On Sheets A-1, A-2, A-4, A-5.
8) All Toilet Subfloors Shall Receive a Tar and Felt Waterproof Membrane.
9) All Stairwell Wall Paint Finish Shall Be Descoglaze △
10) Stair Finishes Scheduled Are Typical For Full Height of The Stair.
11) Delete Painting of Core Walls in Typical Office Space △ CO "54

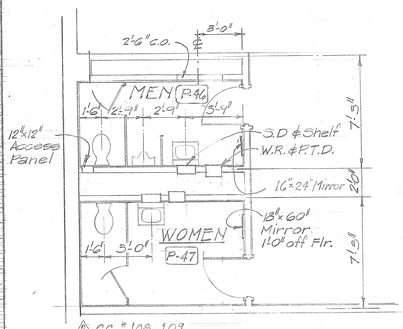

ENLARGED PLAN OF RM'S P-46 & P-47
Scale: 1/4" = 1'-0"

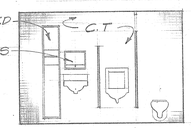

SOUTH WALL P-46

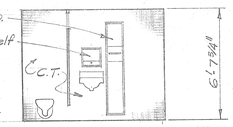

NORTH WALL P-47

FRANKFURT · SHORT · EMERY · McKINLEY ARCHITECTS · ENGINEERS
MEMBER AMERICAN INSTITUTE OF ARCHITECTS
MEMBER AMERICAN SOCIETY OF HEATING, REFRIGERATING AND AIR CONDITIONING ENGINEERS
FSEM

REVISION	DESCRIPTION	DATE
△1	Added Addenda Items	1 Mar. 74
△2	As Built Conditions	1 Mar. 74

KERR-McGEE CENTER
OKLAHOMA CITY OKLAHOMA
ROOM FINISH SCHEDULE

COMM. NO. 366.24
DATE 29 Sept. 1969
SHEET NO. A-18

DOOR SCHEDULE

LOWER BSMT.

DR. NO.	DOOR SIZE	DOOR TYPE	HEAD	JAMS	SILL	HDWR SET	GRILLE SIZE	REMARKS
LB-1	4'-0" x 7'-0" x 1¾"	A	18	18	–	9	36"X76"	
LB-2	2- 3'-0" x 7'-0" x 1¾"	A	18	18	–	10		
LB-3	3'-4" x 6'-6"	—	GO	GO	GT	—		2 Hr. Labeled Vault Door
LB-4	2- 3'-0" x 7'-0" x 1⅜"	A	18	18	–	11		
LB-5	2'-8" x 7'-0" x 1¾"	C	18	18	61	12		
LB-6	3'-0" x 7'-0" x 1¾"	A	43	43	–	13		
LB-7	3'-0" x 7'-0" x 1¾"	A	14	19/14	–	14		
LB-8	3'-0" x 7'-0" x 1¾"	A	14	14	–	14		
LB-9	3'-0" x 7'-0" x 1¾"	A	14	14	–	14		
LB-10	4'-0" x 7'-0" x 1¾"	E	47	47	48	16		
LB-11	3'-0" x 7'-0" x 1¾"	E	47	47	48	15		
LB-12	3'-0" x 7'-0" x 1¾"	E	47	47	48	15		
LB-13	3'-0" x 7'-0" x 1¾"	A	18	18	–	15	(2)24"X12"	One Top · One Bottom
LB-14	3'-0" x 7'-0" x 1¾"	E	47	47	48	17		Metal Astragal (A) CO.#12
(A) ~~LB-15~~	~~3'-0" x 7'-0" x 1¾"~~	~~A~~	~~14~~	~~14~~	~~–~~	~~14~~		Omitted, CO.#10

BASEMENT

B-1	3'-0" x 7'-0" x 1¾"	G	G9/35	G9/11	G1	18		(A) 9"x3"x1¾" Transom
(A) B-2	Relocate Owner Furnished Roll-Up Door							C.O. # 13
B-3	Omitted							
B-4	3'-0" x 7'-0" x 1¾"	E	47	47	48	19		Electr. Jambswitch (A) C.O.#12
B-5	3'-0" x 7'-0" x 1¾"	A	14	14	–	13		
B-6	3'-6" x 7'-0" x 1¾"	A	14	14	–	20		
B-7	3'-6" x 7'-0" x 1¾"	A	16	16	–	21		
B-8						—		
B-9	2- 3'-0" x 7'-0" x 1¾"	A	18	18	–	22		Exist. Door To Remain
B-10	2- 3'-0" x 7'-0" x 1¾"	A	15	15	G1	23		Astragal
B-11	3'-0" x 7'-0" x 1¾"	A	15	15	G1	24		"
B-12	2'-8" x 7'-0" x 1¾"	A	38	38	–	25	20"X12"	
B-13	2'-8" x 7'-0" x 1¾"	A	38	38	–	25	20"X12"	
B-14	2'-8" x 7'-0" x 1¾"	C	18	18	–	26		
B-15	2'-8" x 7'-0" x 1¾"	A	29	29	–	14		
B-16	3'-6" x 7'-0"	L				7		See Det'l Sht. A-29
B-17	2'-8" x 7'-0" x 1¾"	H	1	2	–	27	20"X 6"	(A) 2'-5" x 1'-5" x 1¾" Transom
B-18	2'-8" x 7'-0" x 1¾"	H	1	2/5	–	27	20"X 6"	(A) " " " "
B-19	2'-8" x 7'-0" x 1¾"	H	38	38	12	28		(A) " " " "
B-20	2'-8" x 7'-0" x 1¾"	H	38	38	12	29		(A) " " " "
B-21	2'-8" x 7'-0" x 1¾"	K	5	2/4	62	30		(A) " " " "
B-22	2'-8" x 7'-0" x 1¾"	C	18	19/20	66	32		
B-23	2- 2'-6" x 7'-0" x 1¾"	C(A)	18	18	–	31		Astragal, CO.#12
B-24	2'-8" x 7'-0" x 1¾"	H	11	11	12	27	20"X 6"	(A) 2'-8" x 1'-5" x 1¾" Transom
B-25	2'-8" x 7'-0" x 1¾"	H	G	5	12	28	20"X12"	(A) " " " "
B-26	3'-0" x 7'-0"	L				4		See Det'le Sht. A-29
B-27	3'-0" x 7'-0"	L				4		" " " "
B-28	3'-0" x 7'-0" x 1¾"	H	19	19	–	35	24"X24"	(A) 3'-0" x 1'-5" x 1¾" Transom
B-29	3'-6" x 7'-0"	L				4		See Det'le Sht. A-29
B-30	3'-0" x 7'-0" x 1¾"	A	18	18	–	14		
B-31	2- 3'-6" x 7'-0" x 1¾"	C(A)	18	18		34		Astragal, CO.# 12
B-32	3'-6" x 7'-0" x 1¾"	E	45	44	46	35		
B-33	3'-0" x 7'-0" x 1¾"	A	13	13	–	13		
B-34	20 x 14 x –	M				—		See Det'le Sht. A-24

UPPER BSMT.

UB-1	2'-8" x 7'-0" x 1¾"	C	13	13	–	26	
UB-2	3'-0" x 7'-0" x 1¾"	A	43	43/50	–	13	
UB-3	(A) 4'-0" x 7'-0" x 1¾"	E	47	47	48	36	(A) Add.#1 Pg. 4
UB-4	3'-0" x 7'-0" x 1¾"	E	47	47	48	36	

PLAZA

P-1	3'-0" x 7'-0" x	L				5		See Det'le Sht. A-26
P-2	3'-0" x 7'-0" x	L				5		" " "
P-3	3'-0" x 7'-0" x	L				5		
P-4	3'-0" x 7'-0" x	L				5		
P-5	3'-0" x 7'-0" x 1¾"	H	39	39	–	46		(A) 3'-0" x 2'-5" x 1¾" Transom
P-6	3'-0" x 7'-0" x 1¾"	H	39	39	–	46		(A) " " " "
P-7	3'-0" x 7'-0" x 1¾"	H	39	39	–	47		(A) " " " "
P-8	3'-0" x 7'-0" x 1¾"	E	49	49	48	48		(A) C.O. #10
P-9	2'-8" x 7'-0" x 1¾"	B(A)	39	39	–	33	20"X 8"	(A) 2'-8" x 2'-4½" x 1¾" Transom
P-10	3'-0" x 7'-0" x 1¾"	H	39	39	–	47		(A) 3'-0" x 2'-5" x 1¾" Transom
P-11	2'-6" x 7'-0" x 1¾"	H	39	39	–	47		(A) 2'-0" x " " "
P-12	2'-8" x 7'-0" x 1¾"	K	17	17	–	30		
P-13	2'-8" x 7'-0" x 1¾"	A	29	29	–	27		
P-14	2'-8" x 7'-0" x 1¾"	C	30	31		56		(A) With Metal Transom (Add.#2)
P-15	3'-0" x 7'-0" x 1¾"	B	41	42/42		50		Pocket Door
P-16	2- 2'-8" x 7'-0" x 1¾"	L(A)				51		(A) CO.#12 2'-0" Alum Transom
P-17	(A) 3'-0" x 7'-0" x 1¾"	H	39	39		47		(A) 6'-0" x 2'-5" x 1¾" Transom, CO.#39
P-18	3'-0" x 7'-0" x 1¾"	H	39	39		47		(A) " " " "
P-19	3'-0" x 7'-0" x 1¾"	H	G3	G3		53		(A) Dbl. Acting 2'-4½" Transom
(A) ~~P-20~~	~~2- 2'-8" x 7'-0" x 1¾"~~	~~H~~	~~39~~	~~39~~		~~51~~		Omitted, CO.#12
(A) ~~P-21~~	~~3'-0" x 7'-0" x 1¾"~~	~~H~~	~~39~~	~~39~~		~~54~~		Omitted CO.#12
P-22	3'-0" x 7'-0" x 1¾"	H	38	32/38	12	52	20"X 12"	(A) 3'-0" x 2'-5" x 1¾" Transom
P-23	2- 2'-0" x 7'-0" x 1¾"	H	39	39		51		(A) 2'-6" x 1'-5" x 1¾" "
P-24	3'-0" x 7'-0" x 1¾"	H	38	38	12	52	20"X 12"	(A) 3'-0" x 2'-5" x 1¾" "
P-25	2- 2'-8" x 7'-0"	L				63		See Det'le Sht. A- 26
(A) ~~P-26~~	~~3'-0" x 7'-0" x 1¾"~~	~~A~~	~~15~~	~~15~~	~~G1~~	~~55~~		Omitted, CO.#19
P-27	3'-0" x 7'-0"	L				5		See Det'le Sht. A- 26
P-28	3'-0" x 7'-0"	L				5		" " "
P-29	2'-8" x 7'-0" x 1¾"	K(A)	26	27	24	30		(A) CO.#12

MEZZANINE and SECOND FLOOR PARKING

201	2- 3'-0" x 7'-0" x 1¾" (A)	A	43	43/50		40		(A) Reduce Ht. of Doors By 1½" ± to Fit Conditions (CO.#30)
202	2'-8" x 7'-0" x 1¾" (A)	C	31	31		26		
203	2- 3'-0" x 7'-0" x 1¾" (A)	A	43	43/50		40		
204	2- 3'-0" x 7'-0" x 1¾"	A	43	43		10		
205	3'-6" x 8'-2⅜"	L				8		See Det'ls Sht. A-29
206	3'-6" x 8'-2⅜"	L				2		" " " "
207	2'-8" x 7'-0" x 1¾"	K(A)	25	25		30		(A) CO.#12
208	2'-8" x 7'-0" x 1¾"	H	35/(A) 22/25		24/(A)	27	20"X 6"	(A) Add.#1 Pg. 4
209	2'-8" x 7'-0" x 1¾"	H	35/(A) 22/25		24/(A)	27	20"X 6"	(A) "
210	2'-8" x 7'-0" x 1¾"	K	25	25	24/(A)	30		(A) "
211	2'-8" x 7'-0" x 1¾"	K	25	25	24/(A)	30		(A) "
212	2'-8" x 7'-0" x 1¾"	H	25	25	12	28	20"X12"	
213	2'-8" x 7'-0" x 1¾"	H(A)	11	9/11	12	27	20"X 6"	(A) Ceramic Tile Both Sides of Sill
214	2'-8" x 7'-0" x 1¾"	H(A)	11	11	12	27	20"X 6"	(A) Add.#1 Pg. 4
215	2'-8" x 7'-0" x 1¾"	H	25	25	12	28	20"X12"	
216	2'-8" x 7'-0" x 1¾"	H	11	9/11	12	27		
217	2- 3'-0" x 7'-0" x 1¾"	A	43	43	–	10		
218	2- 3'-0" x 7'-0" x 1¾"	A	13	13	G1	41		
219	2- 3'-0" x 7'-0" x 1¾"	A	13	13	G1	41		
220	2'-8" x 7'-0" x 1¾"	C	13	13		26		
221	2- 3'-0" x 7'-0" x 1¾"	A	43	43		10		
222	2- 3'-0" x 7'-0" x 1¾"	A	43	43/50		10		
223	2- 3'-0" x 7'-0" x 1¾"	A	43	43/50		10		
~~224~~	~~(A) 3'-0" x 7'-0" x 1¾"~~	~~A~~	~~18~~	~~18~~		~~42~~		Omitted, CO.#21
225	Omitted.							
226	2'-8" x 7'-0" x 1¾"	H	25	27	24	27		

THIRD FLOOR TOWER and PARKING

DR NO.	DOOR SIZE	DOOR TYPE	HEAD	JAMS	SILL	HDWR SET	GRILLE SIZE	REMARKS
301	2'-8" x 7'-0" x 1¾"	C	31	31	G2	26		
302	2'-8" x 7'-0" x 1¾"	C(A)	31	31	62	39		(A) Add.#3 Pg. 4
303	2'-8" x 7'-0" x 1¾"	C	18	18		26		
304	2'-8" x 7'-0" x 1¾"	A	2	2/17		14	20"X 6"	
305	2'-8" x 7'-0" x 1¾"	A	2	2/17		14	20"X 6"	
306	2'-8" x 7'-0" x 1¾"	C	13	13/26	26	38		
307	2'-8" x 7'-0" x 1¾"	C	18	13/60	86	38		
308	Omitted							
~~309~~	~~(A) 2'-8" x 7'-0" x 1¾"~~	~~A~~	~~7~~	~~8/9~~	~~32~~	~~14~~	~~(2)20"X6"~~	Omitted CO.#12

TYPICAL FLOORS

T-01	2'-8" x 7'-0" x 1¾"	H	1	2/5	–	14	20"X 6"	
T-02	2'-8" x 7'-0" x 1¾"	H	1	2/5	–	14	20"X 6"	
T-03	2'-8" x 7'-0" x 1⅜"	K	5	3/4 36a		26		(A) Added Marble Thrhld. (CO.#47)
T-04	2'-8" x 7'-0" x 1¾"	K	5	3/4 36a		26		(A) " " " "
T-05	2'-8" x 7'-0" x 1¾"	H	G	5	12	25	20"X12"	
T-06	2'-8" x 7'-0" x 1¾"	H	7	8/9	32	14	(2)20"X6"	1 @ Top & 1 @ Bottom
T-07	2'-8" x 7'-0" x 1¾"	H	G	3	12	25	20"X12"	
T-08	2'-8" x 7'-0" x 1¾"	—	"	12/11	—	—		Cased Opng
T-09	(A) 3'-6" x 7'-0" x 1¾"		G4	G4	—	37		(A) CO.#12

EIGHTEENTH FLOOR

1801	Omitted							

NINETEENTH FLOOR

1901	3'-0" x 7'-0" x 1¾"	K	5	4		14		
1902	2'-8" x 7'-0" x 1¾"	K(A)	5	4		14		(A) CO.#12
1903	2'-8" x 7'-0" x 1¾"	A	18	18		14	20"x 6"	

THIRTIETH FLOOR


3001	2'-8" x 7'-0" x 1¾"	A	18	18/18	–	14	24"X12"	
3002	2'-8" x 7'-0" x 1¾"	C	18	18/70	G2	38		
3003	2'-8" x 7'-0" x 1¾"	C	18	18/70	G2	38		
3004	3'-0" x 7'-0" x 1¾	C	18	18	–	38		

TOWER ROOF

R-1	3'-0" x 7'-0" x 1¾"	A	14	14		14	
R-2	3'-0" x 7'-0" x 1¾"	C(A)	14	14		45	(A) CO.#12
R-3	2'-8" x 7'-0" x 1¾"	C(A)	31	31	62	43	(A) CO.#12
R-4	3'-0" x 7'-0" x 1¾"	C	31	31	61	44	
R-5	(A) 3'-6" x 7'-0" x 1¾"	A	31	31	G2	43	(A) CO.#13

DOOR TYPES

(A) Hollow Metal
(B) Wood - Solid Core
(C) Hollow Metal 1½ Hr. "B" Label
(D) Wood - Solid Core (A) Add.#3 Pg. 4 1½ Hr. "B" Label
(E) Hollow Metal Class "A"
(F) Aluminum Duranodic Finish 1½ Hr. "B" Label
(G) Hollow Metal
(H) Wood - Solid Core
(J) Omitted
(K) Wood Veneer 1½ Hr. "B" Label

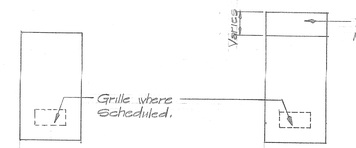





(L) Glass Alum. Frame



(M) Metal - Roll-up

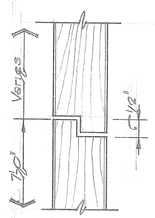

TYP. WOOD TRANSOM
Half Scale:

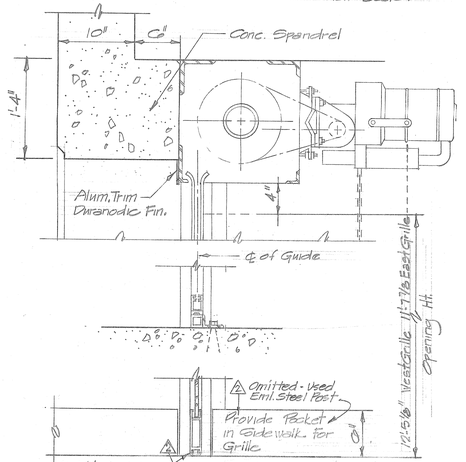

ROLLING GRILLE DETAILS
(HTS)

FSEM

FRANKFURT · SHORT · EMERY · McKINLEY ARCHITECTS · ENGINEERS

MEMBER AMERICAN INSTITUTE OF ARCHITECTS


MEMBER AMERICAN SOCIETY OF HEATING, REFRIGERATING AND AIR CONDITIONING ENGINEERS

REVISION	DESCRIPTION	DATE
1	Added Addenda Items	1 Mar. 74
2	As Built Conditions	1 Mar. 74
3		
4		
5		
6		


KERR-McGEE CENTER
OKLAHOMA CITY, OKLAHOMA

DOOR SCHEDULE


COMM. NO. 3666.24
DATE 29 Sept. 1969
SHEET NO. A-19

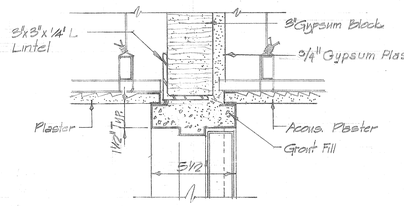


1 HEAD

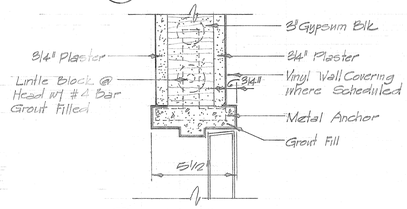


2 JAMB

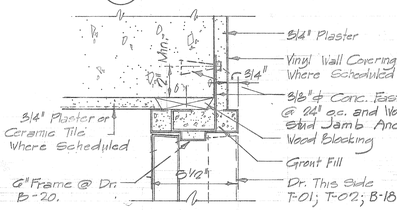


3 JAMB

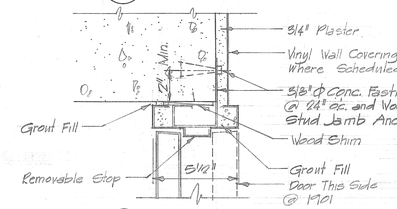


4 JAMB

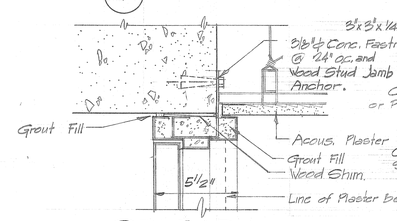


5 HEAD

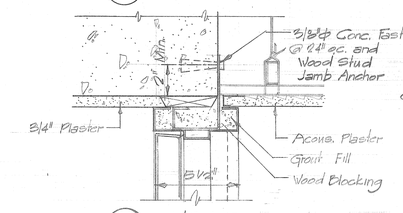


6 HEAD

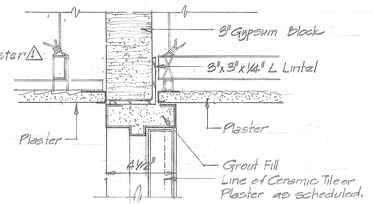


7 HEAD

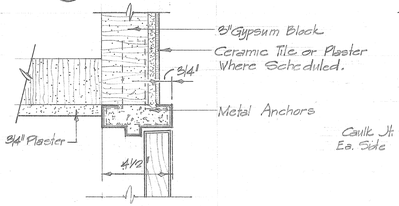


8 JAMB

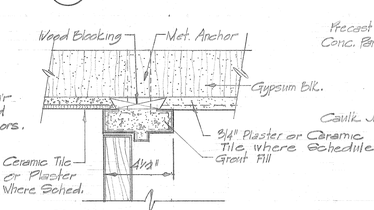


9 JAMB

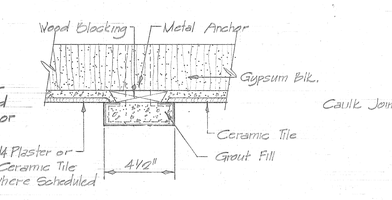


10 JAMB

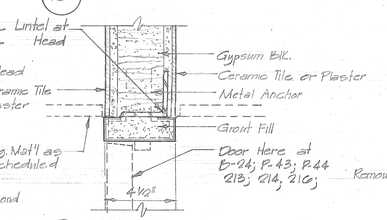


11 JAMB

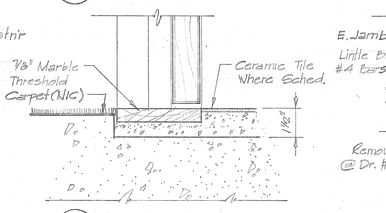


12 SILL

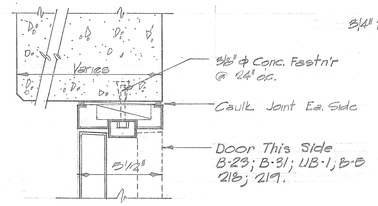


13 JAMB Head Similar

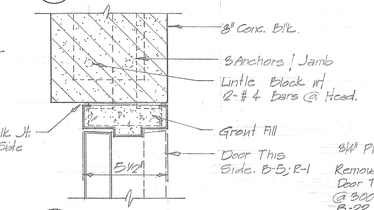


14 JAMB Head Similar

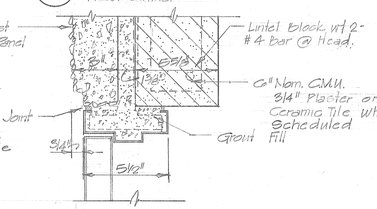


15 JAMB Head Similar

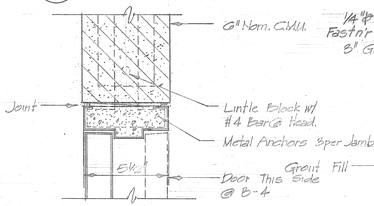


16 JAMB Head Similar

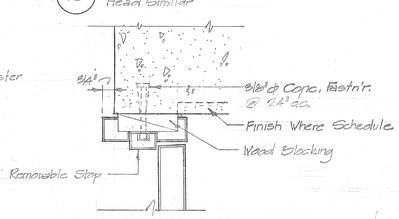


17 JAMB Head Similar

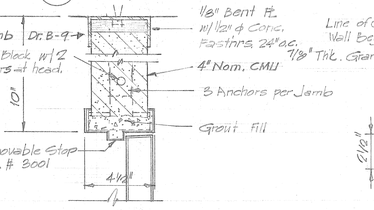


18 JAMB Head Similar

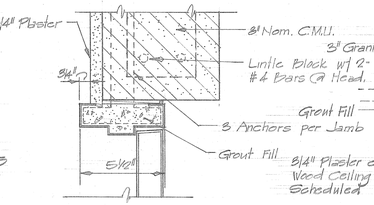


19 JAMB Head Similar

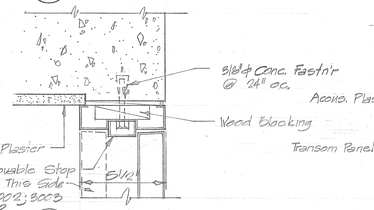


20 JAMB

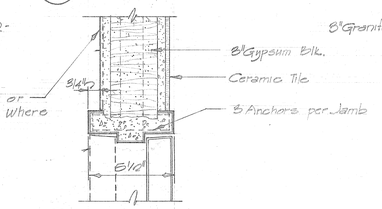


21 JAMB

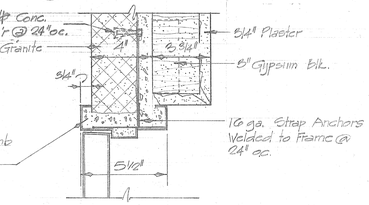


22 JAMB

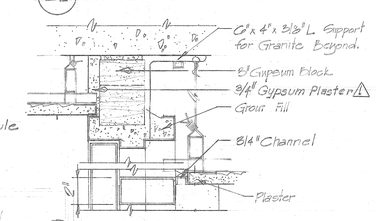


23 HEAD

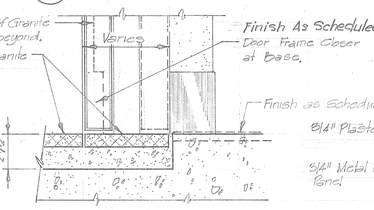


24 SILL

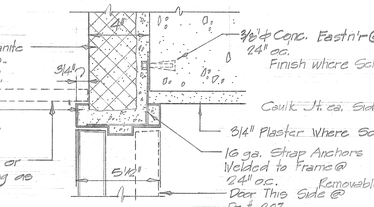


25 JAMB Head Similar

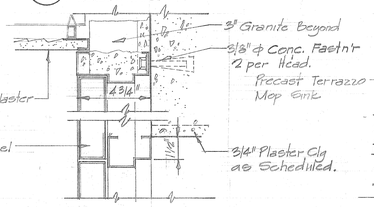


26 HEAD

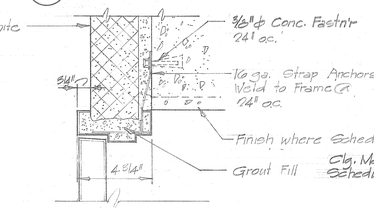


27 JAMB

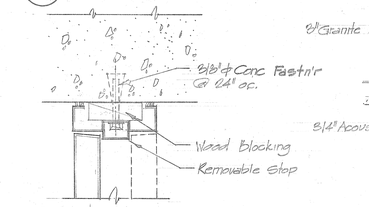


28 JAMB

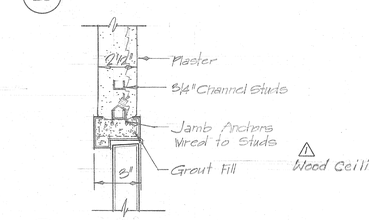


29 JAMB

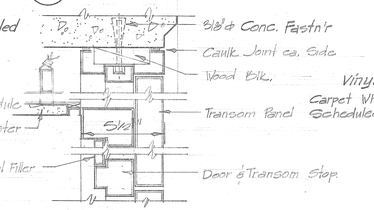


30 HEAD

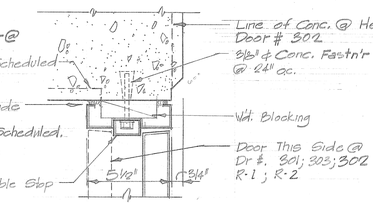


31 JAMB Head Similar

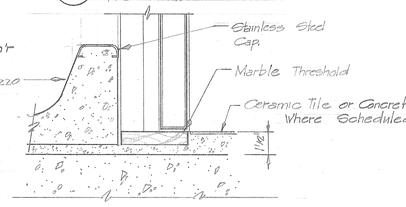


32 SILL

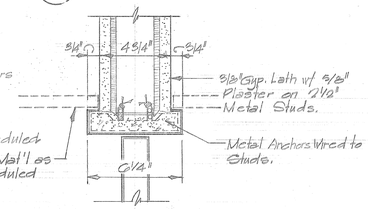

33 JAMB

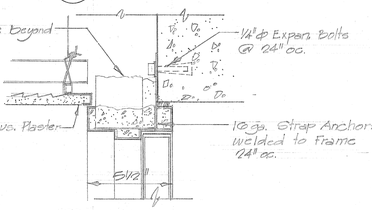


34 HEAD

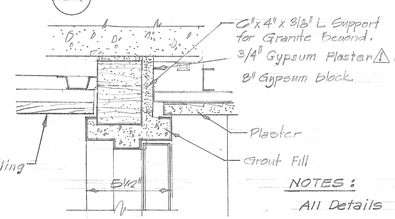

35 HEAD

NOTES:
All Details Scale: 3" = 1'-0"
All Door Frames 1 1/2" Face Width

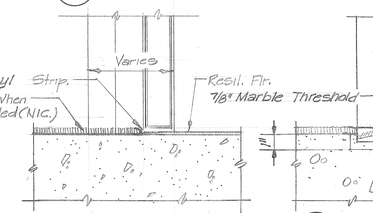

36 SILL

2

36a SILL

FSEM

FRANKFURT · SHORT · EMERY · McKINLEY ARCHITECTS · ENGINEERS

MEMBER AMERICAN INSTITUTE OF ARCHITECTS

MEMBER AMERICAN SOCIETY OF HEATING, REFRIGERATING AND AIR CONDITIONING ENGINEERS

REVISION	DESCRIPTION	DATE
1	Added Addenda Items	1 Mar. 74
2	As Built Conditions	1 Mar. 74
3		
4		
5		
6		


KERR-McGEE CENTER
OKLAHOMA CITY, OKLAHOMA

DOOR DETAILS


COMM. NO. 6606/24

DATE 27 Sept. 1973


SHEET NO. A-20

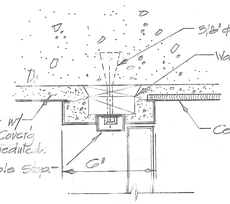


37 JAMB

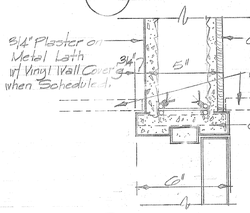


38 JAMB
Head Similar

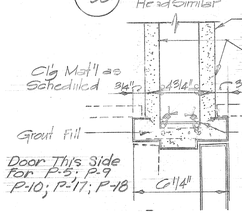


39 JAMB
Head Similar

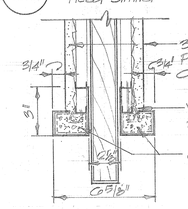

40 JAMB

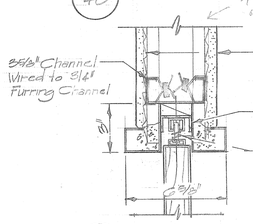


41 HEAD

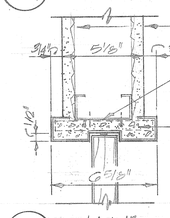


42 JAMB


48 JAMB
Head Similar

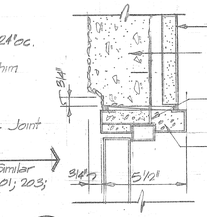

44 JAMB

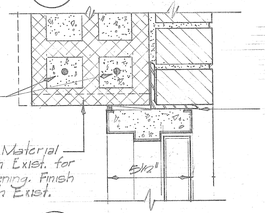


45 HEAD

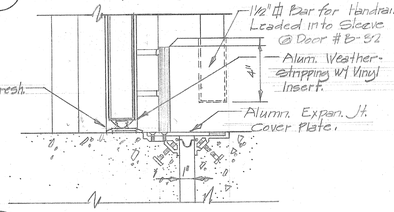


46 SILL

47 JAMB
Head Similar.

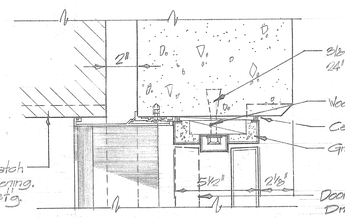


Note: ⚠ Add. #2 Pg. 7
See Detail 45 for Lintel Detail


43 SILL

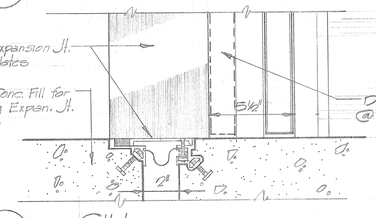


49 JAMB
Head Similar - See Det'l 45 for Exist'g Wall Lintle.

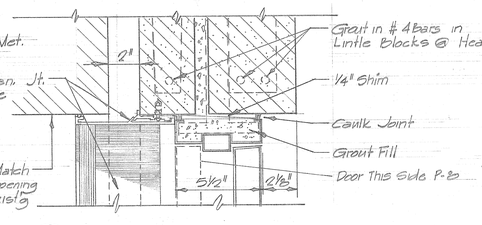

50 JAMB

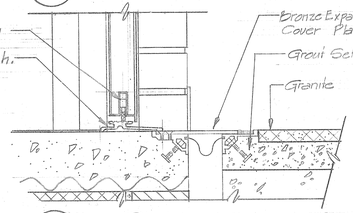


51 SILL

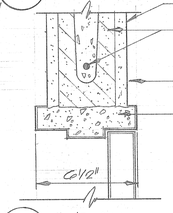


52 HEAD


53 JAMB

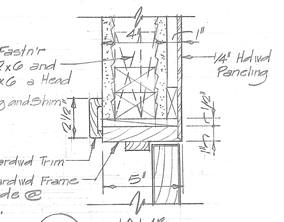


54 SILL

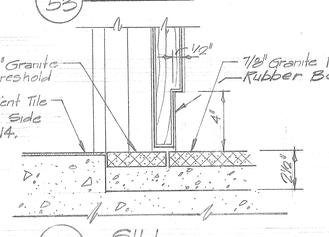


55 JAMB

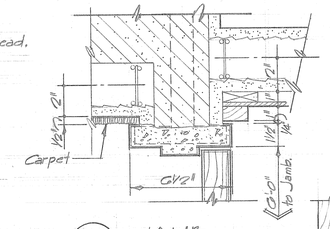


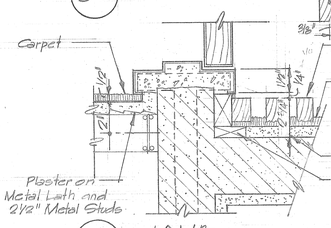


56 JAMB

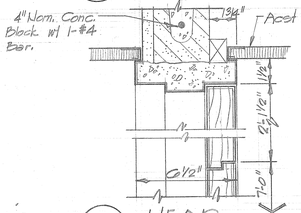


57 HEAD

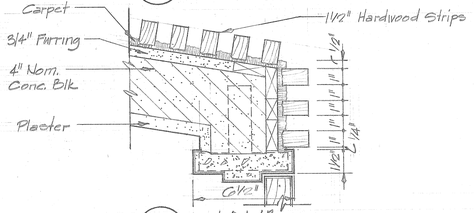

58 JAMB
Opp Jamb Similar

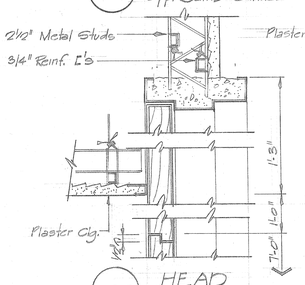



59 HEAD

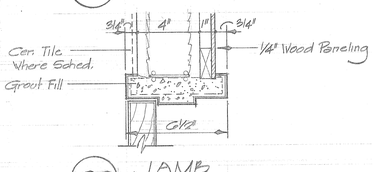


60 JAMB

61 SILL

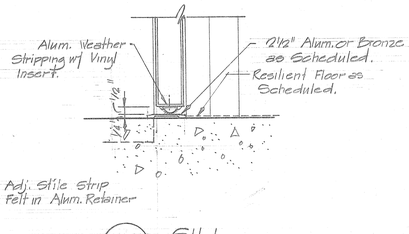


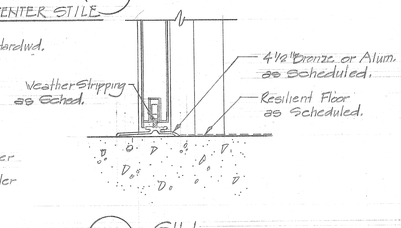


62 SILL

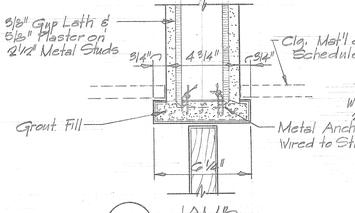


63 JAMB
Head Similar

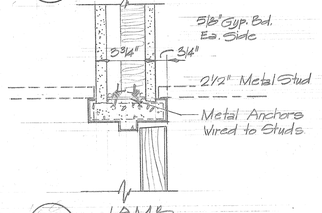

64 JAMB
Head Similar

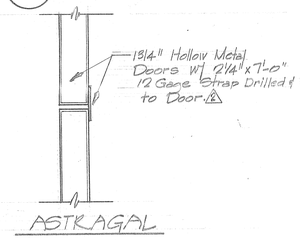



ASTRAGAL

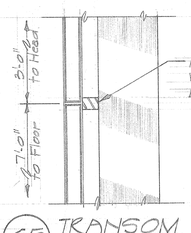


65 TRANSOM

66 HEAD
Jamb. Similar.

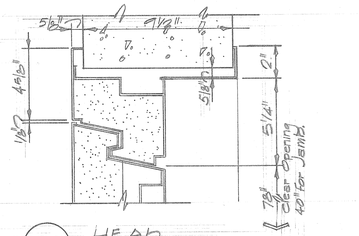


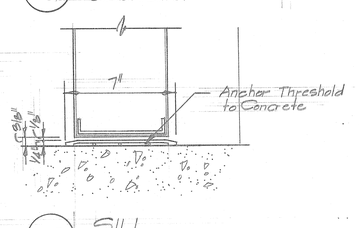


67 SILL

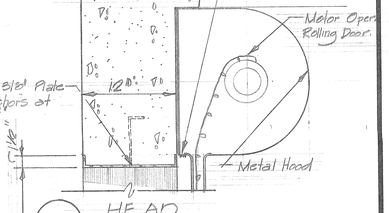


68 HEAD

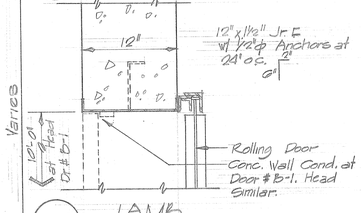

67 JAMB

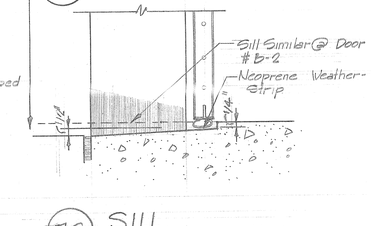

70 SILL

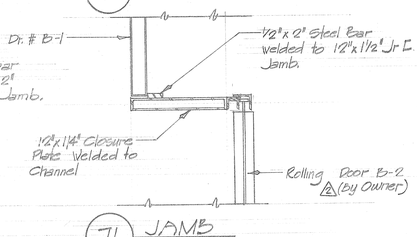

71 JAMB

FSEM

FRANKFURT · SHORT · EMERY · McKINLEY **ARCHITECTS · ENGINEERS**

MEMBER AMERICAN INSTITUTE OF ARCHITECTS


MEMBER AMERICAN SOCIETY OF HEATING, REFRIGERATING AND AIR CONDITIONING ENGINEERS

REVISION	DESCRIPTION	DATE
1	Added Addenda Items	1 Mar. 74
2	As Built Conditions	1 Mar. 74
3		
4		
5		
6		

KERR-McGEE CENTER
OKLAHOMA CITY, OKLAHOMA

DOOR DETAILS

COMM. NO. 8660.24
DATE 29 Sept. 1969
SHEET NO. A-21

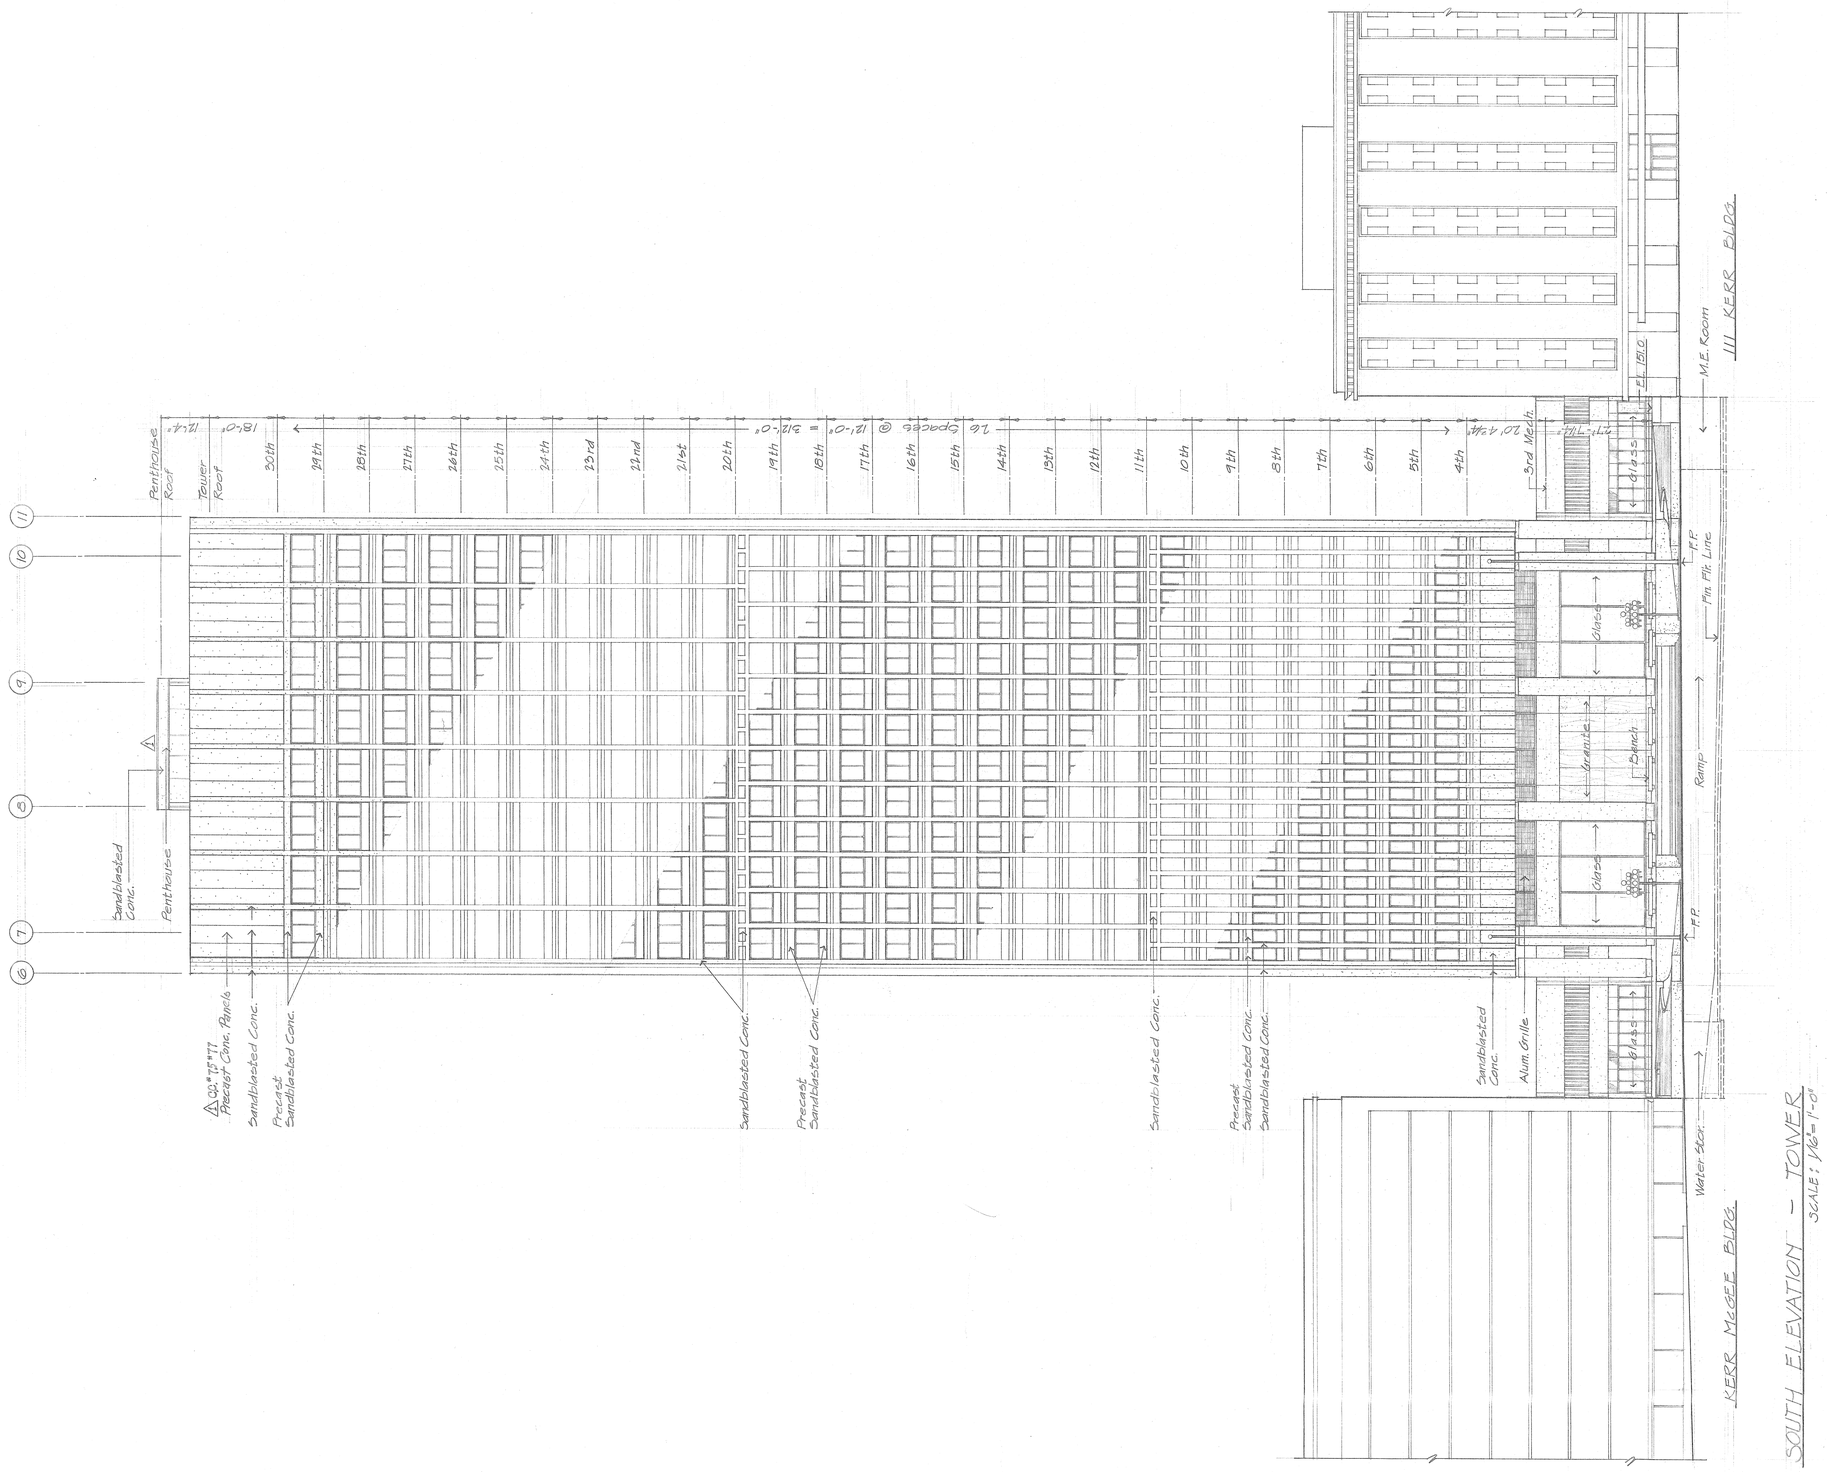

SOUTH ELEVATION - TOWER

SCALE: 1/16"=1'-0"

FRANKFURT · SHORT · EMERY · McKINLEY **ARCHITECTS · ENGINEERS**

MEMBER AMERICAN INSTITUTE OF ARCHITECTS

MEMBER AMERICAN SOCIETY OF HEATING, REFRIGERATING AND AIR CONDITIONING ENGINEERS

REVISION	DESCRIPTION	DATE
1	As Built Conditions	1 Mar. 74
2		
3		
4		
5		
6		

KERR-McGEE CENTER
OKLAHOMA CITY OKLAHOMA

SOUTH ELEVATION
TOWER

COMM. NO. 366624
DATE 29 Sept. 1969
SHEET NO. A-22



FSEM

FRANKFURT · SHORT · EMERY · McKINLEY

MEMBER AMERICAN INSTITUTE OF ARCHITECTS

ARCHITECTS · ENGINEERS


MEMBER AMERICAN SOCIETY OF HEATING, REFRIGERATING AND AIR CONDITIONING ENGINEERS

REVISION	DESCRIPTION	DATE
1	As Built Conditions	1 Mar. 74
2		
3		
4		
5		
6		

KERR-McGEE CENTER
OKLAHOMA CITY OKLAHOMA

EAST ELEVATION
TOWER AND
PARKING STRUCTURE


COMM. NO. 5662.4
DATE 29 Sept. 1969
SHEET NO. A-23

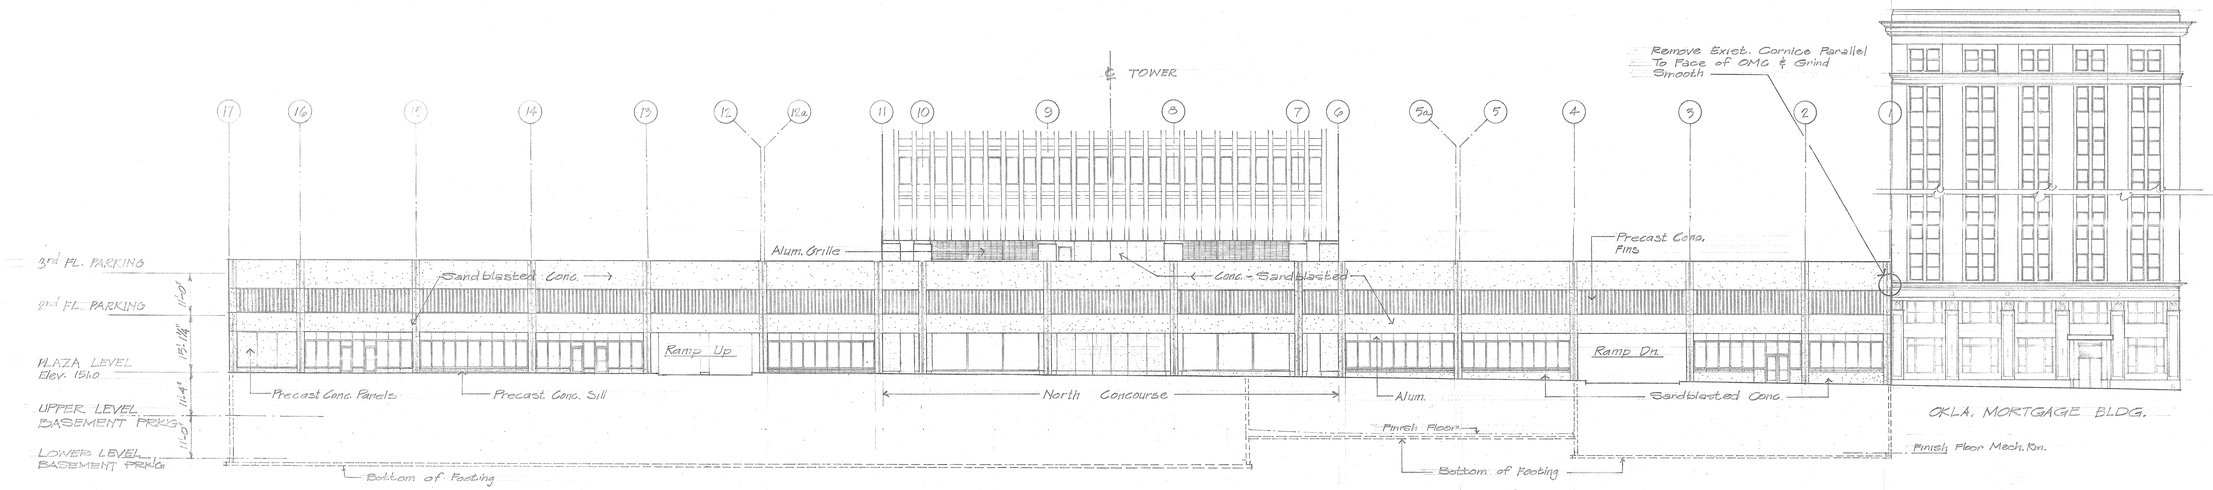


NORTH ELEVATION OF PARKING (TOWER ELEVATION SAME AS SOUTH ELEVATION)

Scale: 1/16" = 1'-0"


⚠ NOTE: All Precast DBL. Tees Are 8'-0" O.C. W/ 32" Depth

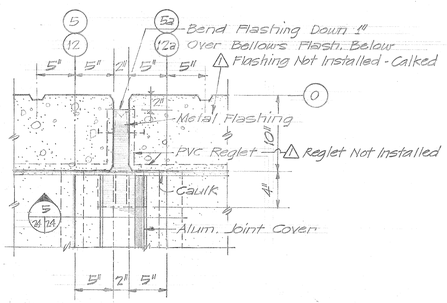

4/5/24 PLAN DETAIL

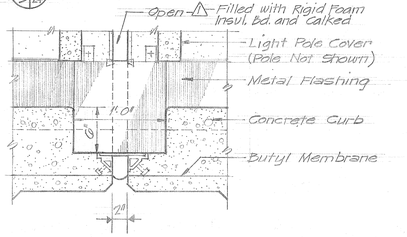

5/24/24 ELEVATION

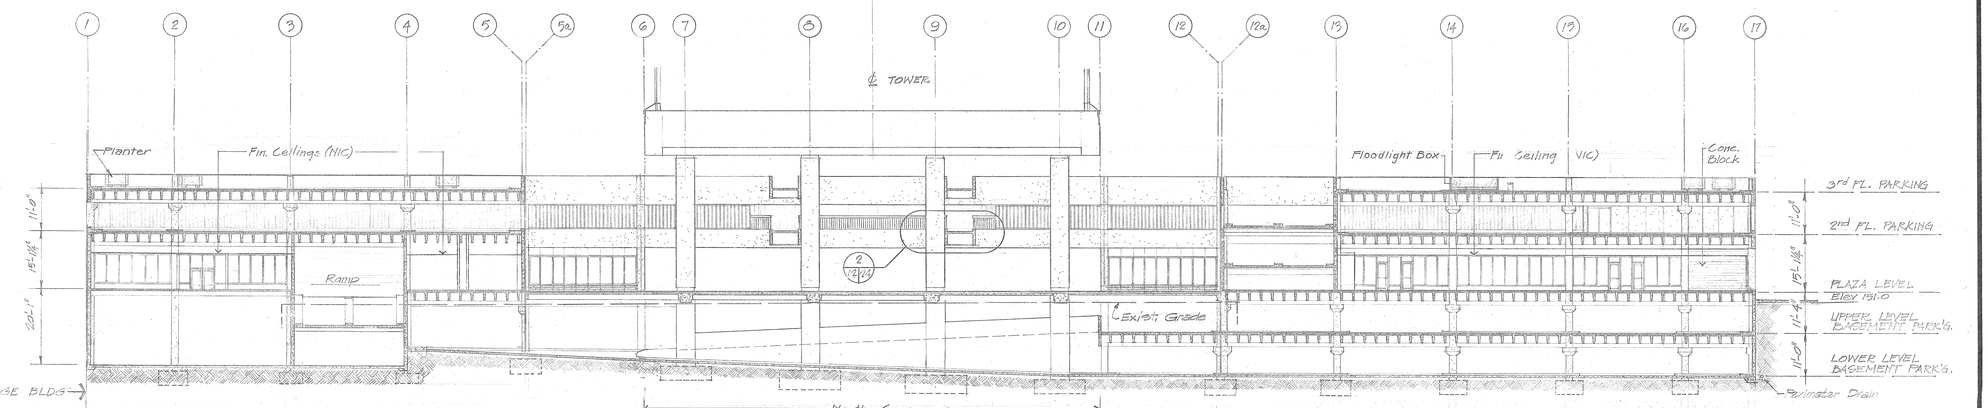


SOUTH ELEVATION — SECTION OF PARKING and NORTH FACE OF TOWER


1/24/24

EXPANSION JOINT DETAILS

Scale: 1 1/2" = 1'-0"

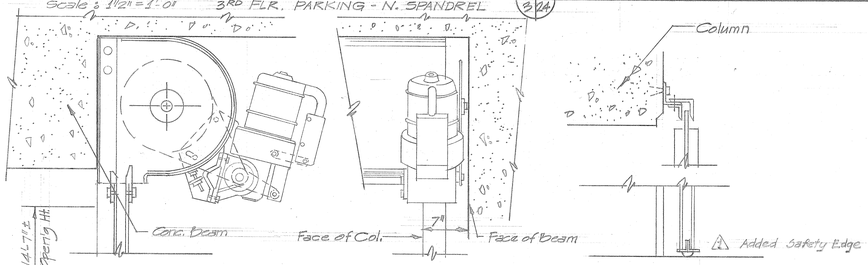

6/24/24 ROLLING DOOR DETAILS N.T.S.

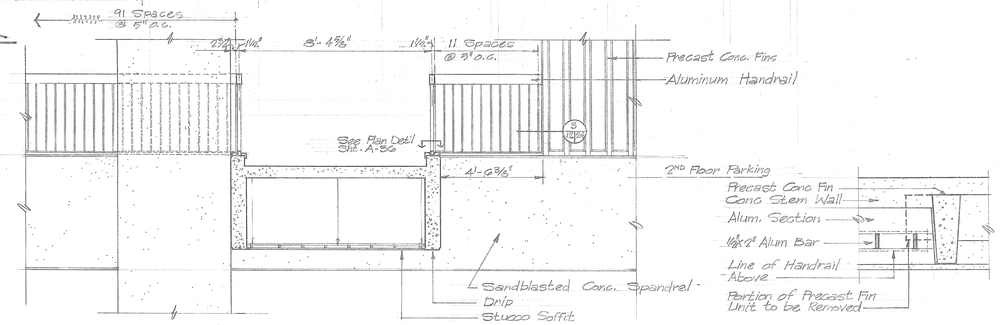

2/12/24 SECTION THRU CROSSWALK
Scale: 3/8" = 1'-0" Looking North

3/12/24 INTERSECTION — Handrail w/ Precast Fins
Scale: 1 1/2" = 1'-0"

FSEM

FRANKFURT · SHORT · EMERY · McKINLEY **ARCHITECTS · ENGINEERS**

MEMBER AMERICAN INSTITUTE OF ARCHITECTS


MEMBER AMERICAN SOCIETY OF HEATING, REFRIGERATING AND AIR CONDITIONING ENGINEERS

REVISION	DESCRIPTION	DATE
1	As Built Condition	1 Mar. 74
2		
3		
4		
5		
6		

KERR-McGEE CENTER
OKLAHOMA CITY, OKLAHOMA


ELEVATIONS
PARKING STRUCTURE

COMM. NO. 8226.24
DATE 27 Sept. 1968
SHEET NO. A-24

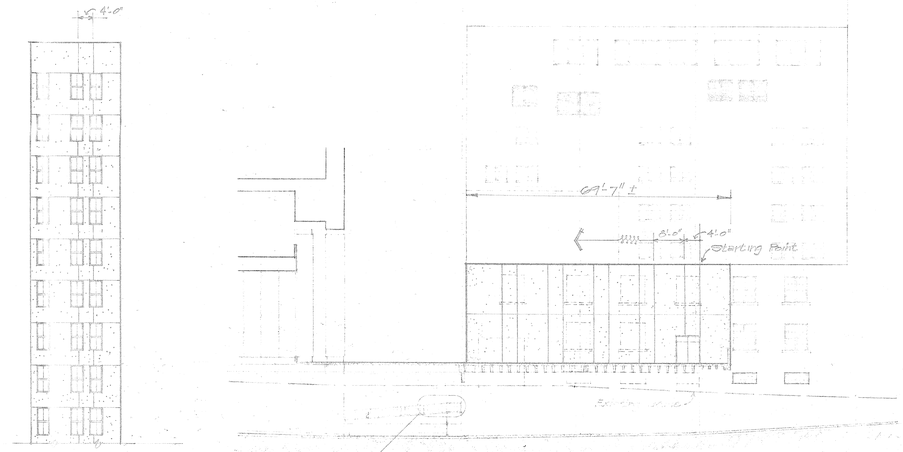


ELEVATION — Okla. Mortgage Bldg. - See Note on East Elev. OMC.


EAST — WEST SECTION THRU ℄ ALLEY
Scale: 1/16" = 1'-0"

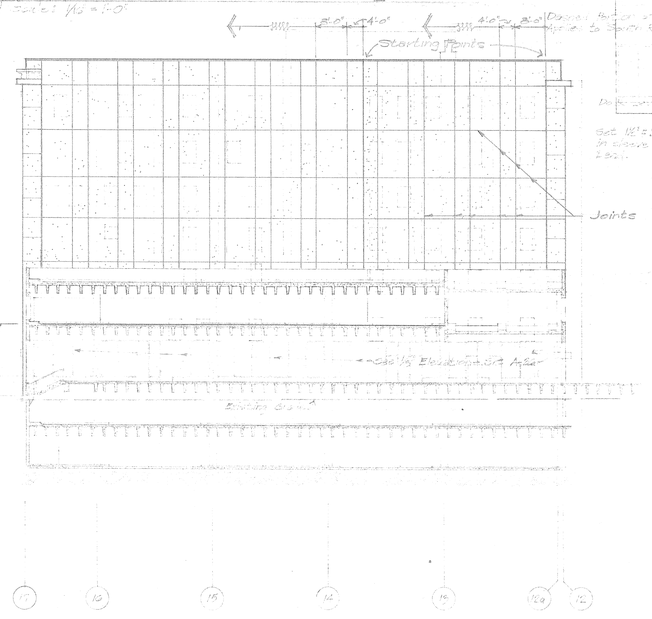


EAST — WEST SECTION THRU ℄ PLAZA
Scale: 1/16" = 1'-0"
North Wall of 111 KERR Bldg.

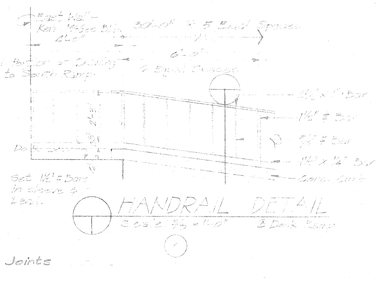


HANDRAIL DETAIL
Scale: 1½" = 1'-0"

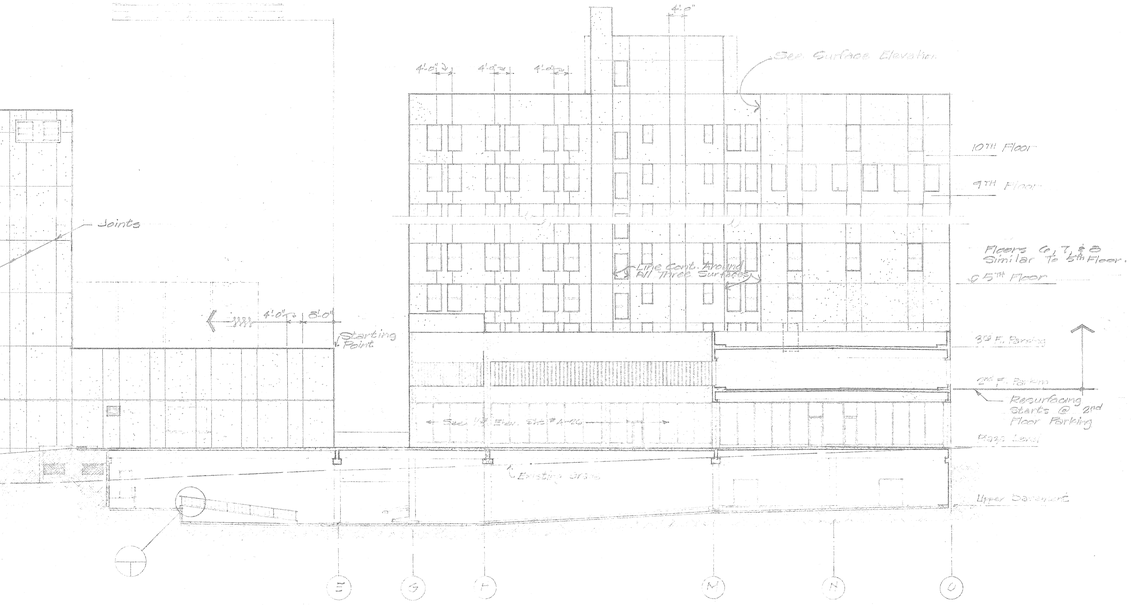


SOUTH — NORTH SECTION THRU PLAZA AT SHOP AREA 'A'
Scale: 1/16" = 1'-0"
East Walls of KERR-McGEE Bldg. and OKLA. MORTGAGE Bldg.

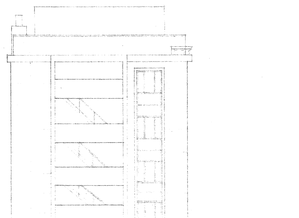

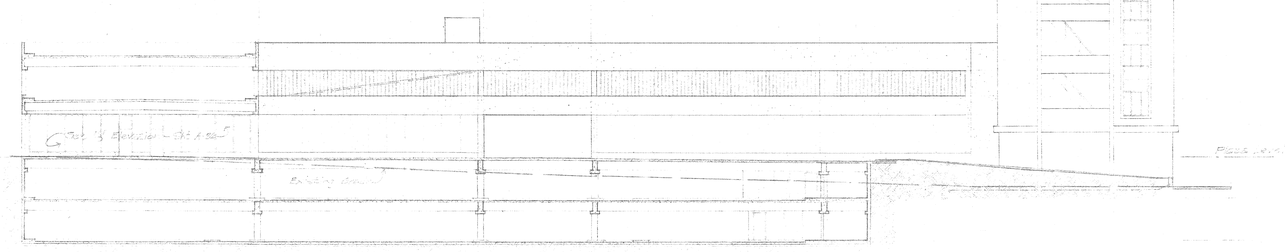

NORTH — SOUTH SECTION THRU PLAZA AT SHOP AREA 'B'
Scale: 1/16" = 1'-0"

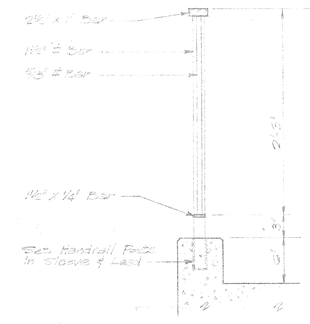

HANDRAIL @ DOCK
Scale: 1½" = 1'-0"

FSEM

FRANKFURT · SHORT · EMERY · McKINLEY ARCHITECTS · ENGINEERS


MEMBER AMERICAN INSTITUTE OF ARCHITECTS

MEMBER AMERICAN SOCIETY OF HEATING, REFRIGERATING AND AIR CONDITIONING ENGINEERS


REVISION	DESCRIPTION	DATE
1		
2		
3		
4		
5		
6		

JOINT PATTERNS FOR RESURFACING EXISTING KERR-McGEE PROPERTIES


COMM. NO. 8667A
DATE 12 AUG. 69
SHEET NO. A-25A

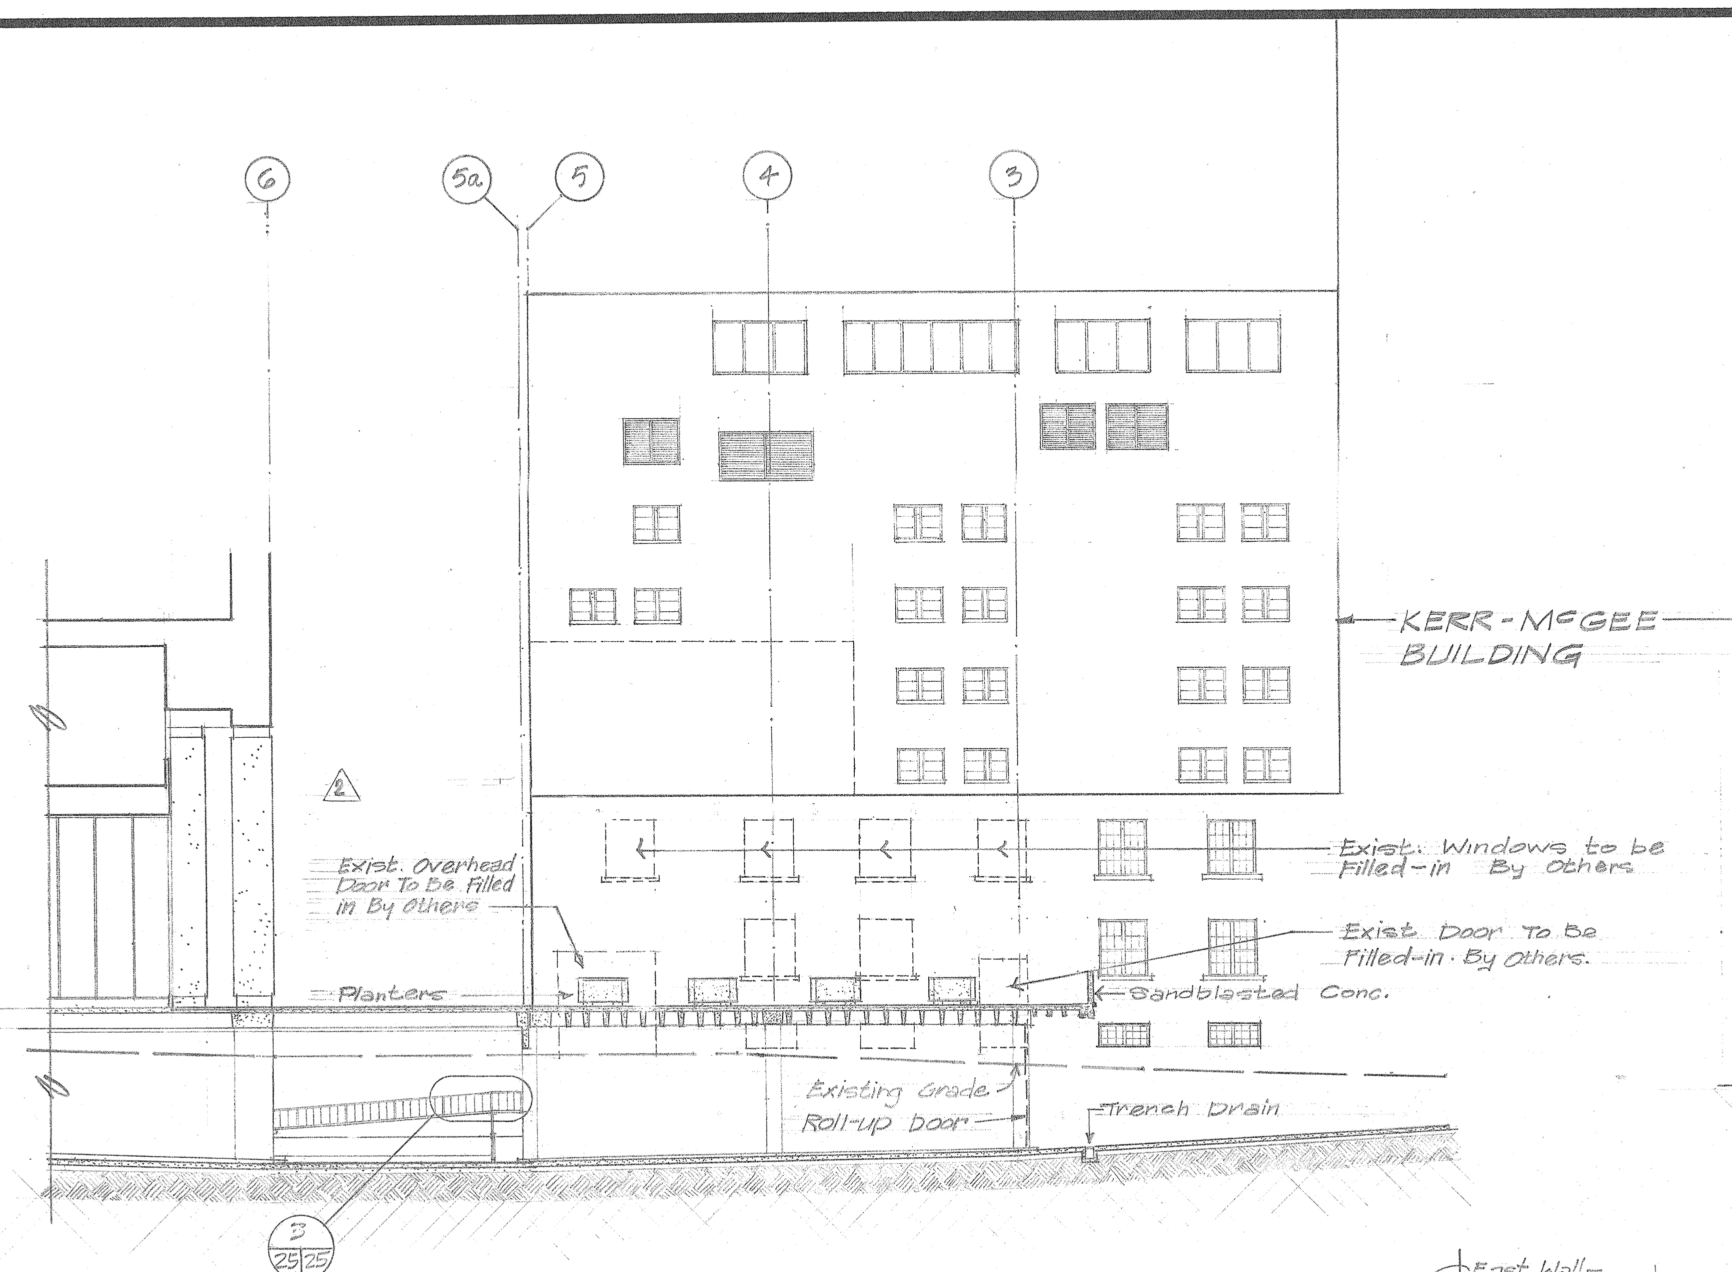


1 3|25 EAST—WEST SECTION THRU ℄ ALLEY
Scale: 1/16" = 1'-0"

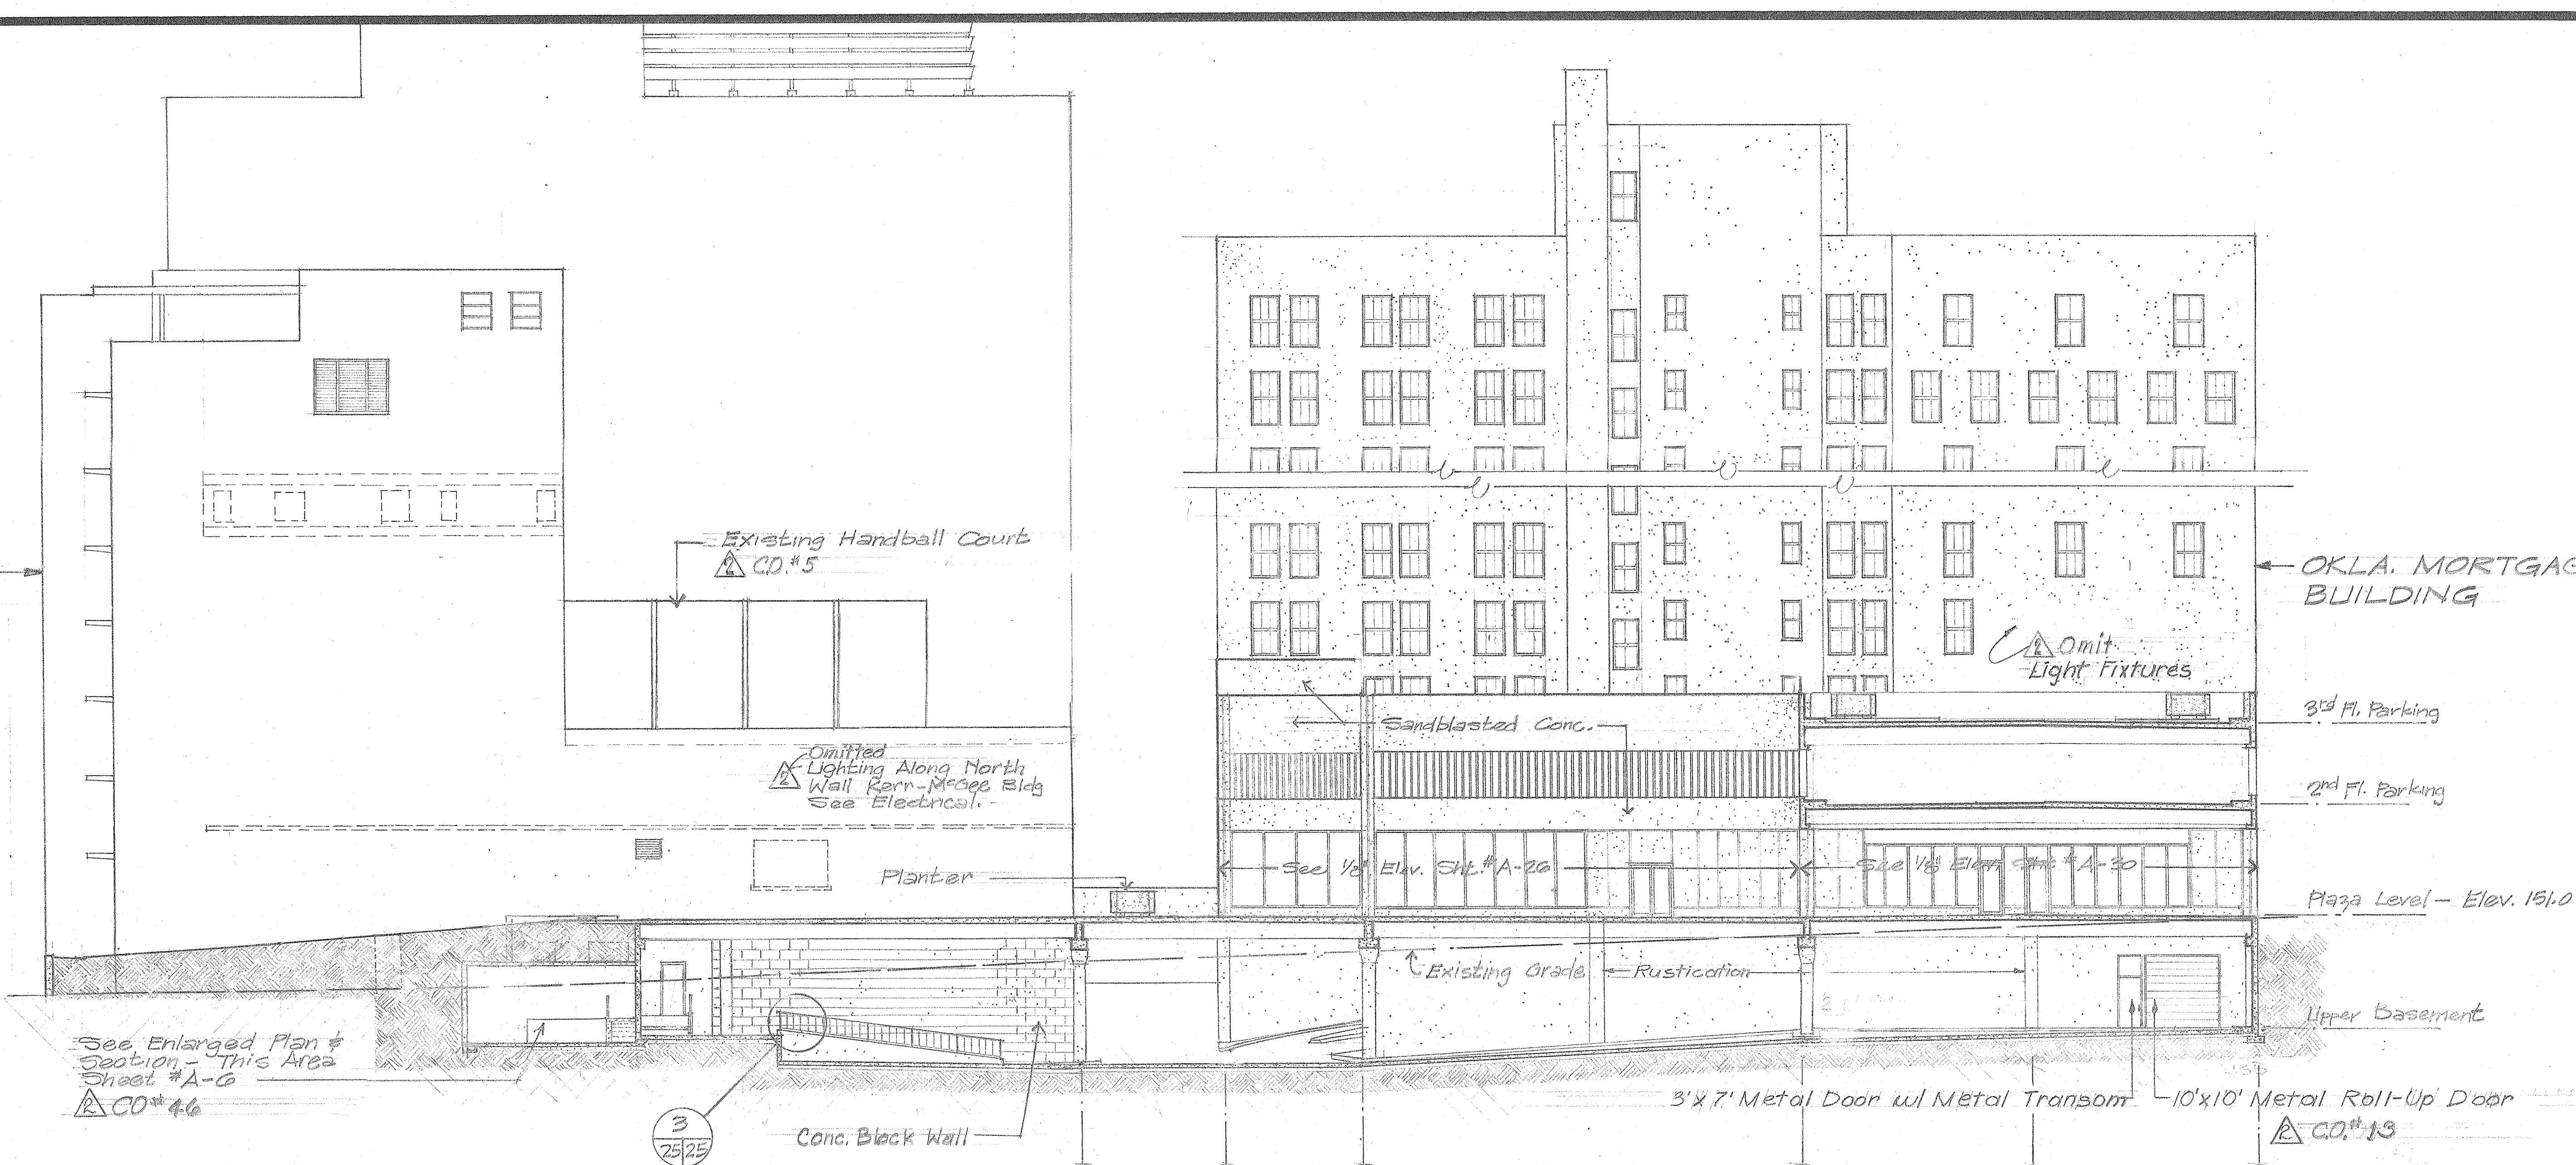


2 3|25 SOUTH—NORTH SECTION THRU PLAZA AT SHOP AREA "A"
Scale: 1/16" = 1'-0"

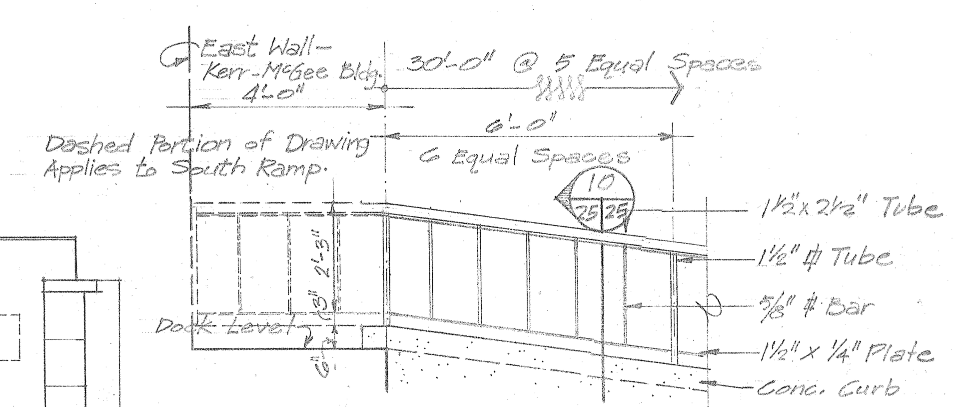


3 25|25 HANDRAIL DETAIL
Scale: 3/8" = 1'-0" @ Dock Ramp

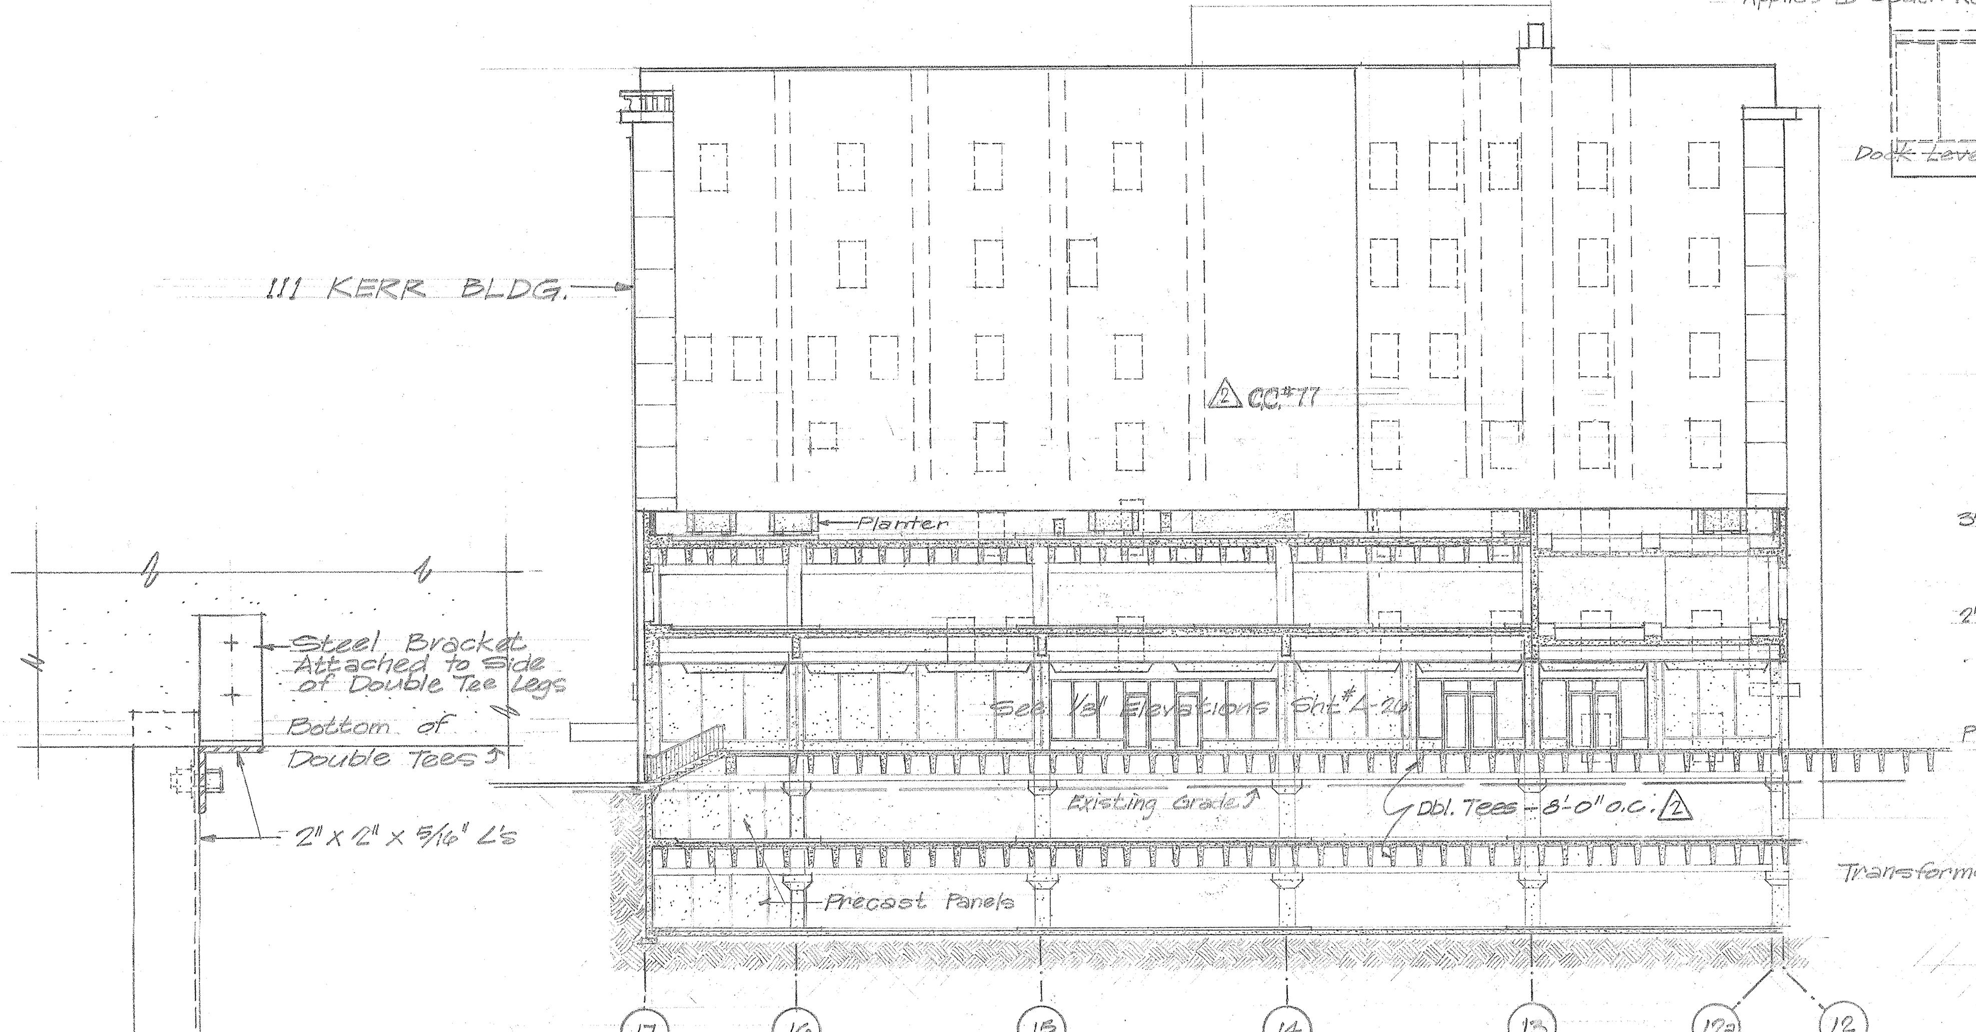


4 3|25 EAST—WEST SECTION THRU ℄ E. CONCOURSE
Scale: 1/16" = 1'-0"

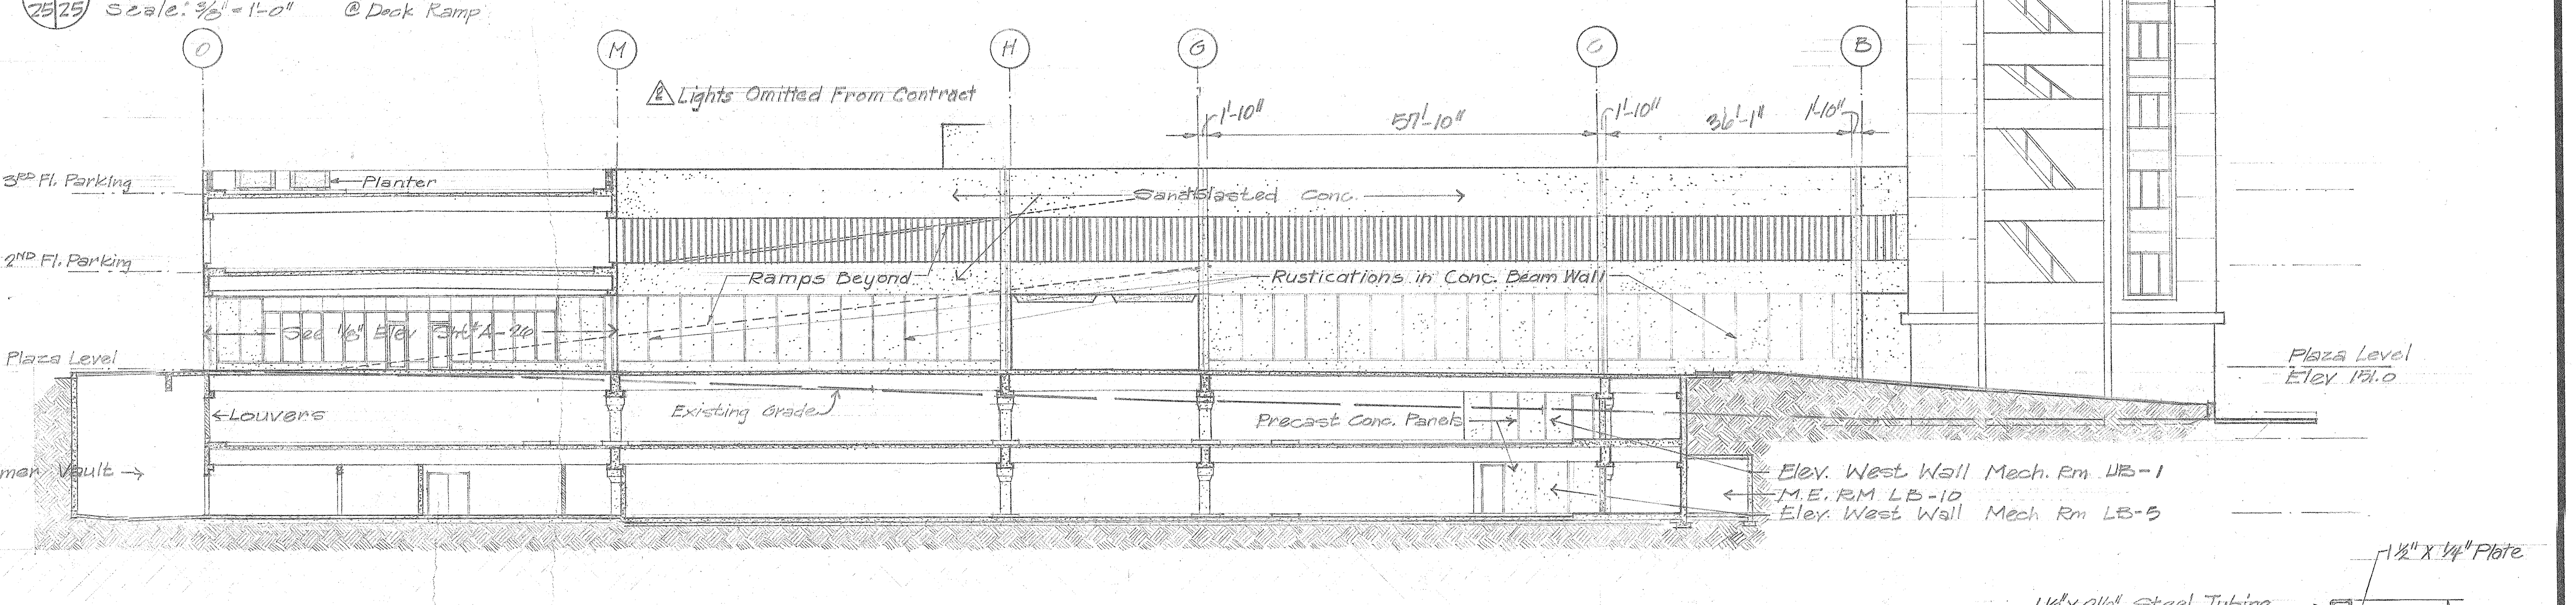


5 3|25 NORTH—SOUTH SECTION THRU PLAZA AT SHOP AREA "B"
Scale: 1/16" = 1'-0"

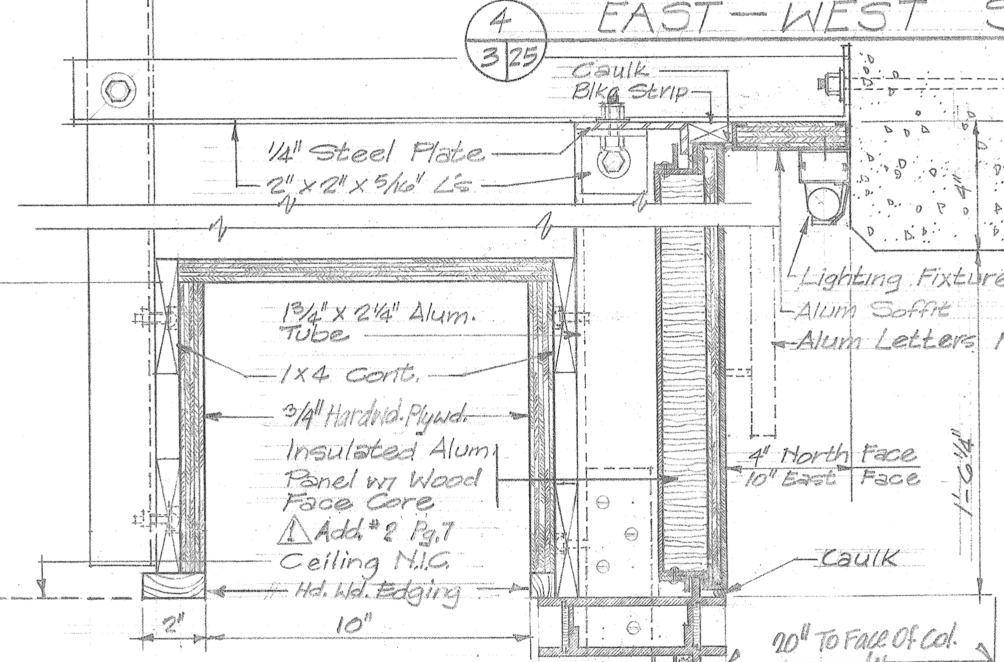


6 26|25 HEAD AT RECESSED WINDOW WALL W/ Drapery Pocket
Scale: 3" = 1'-0"

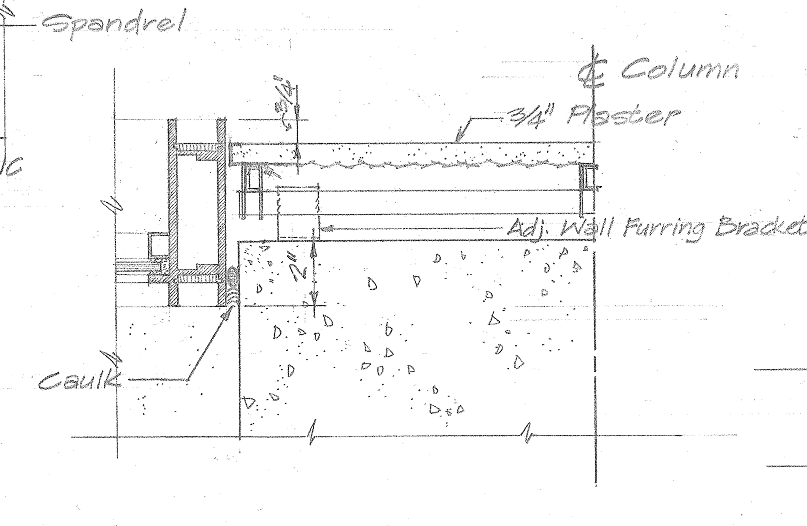


7 26|25 JAMB—RECESSED
Scale: 3" = 1'-0"

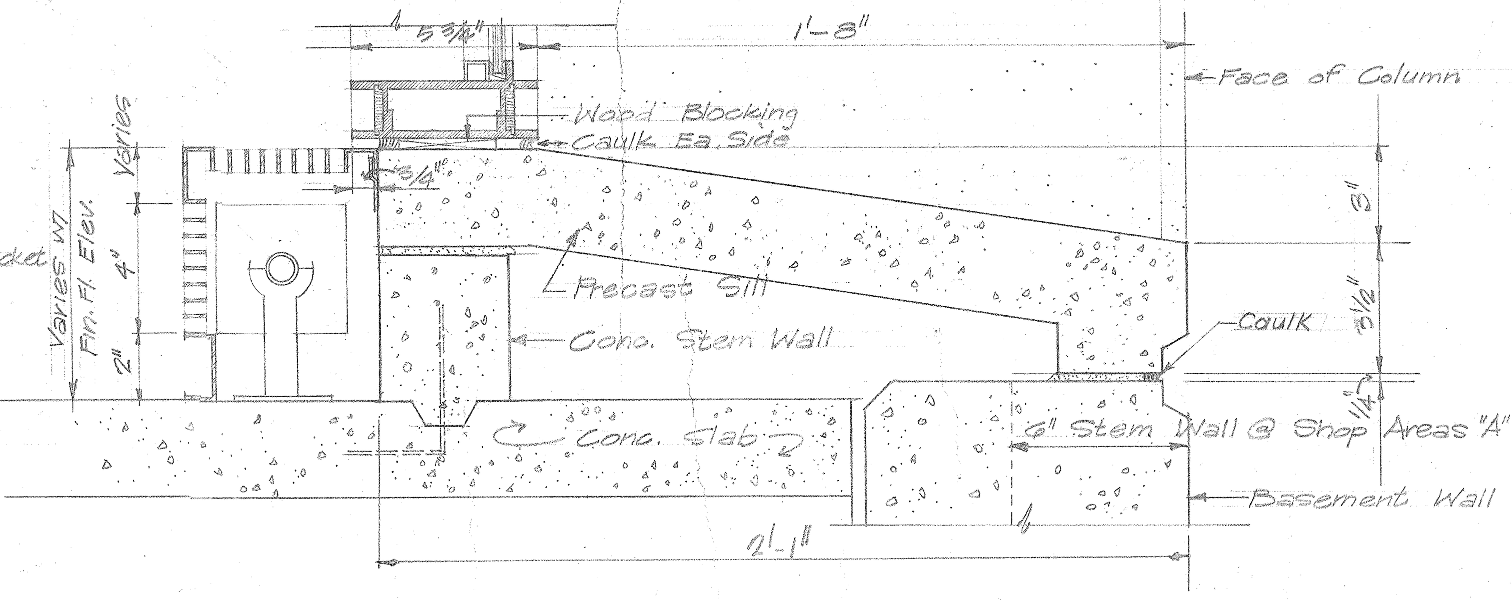

8 26|25 SILL AT RECESSED WINDOW WALL
Scale: 3" = 1'-0"

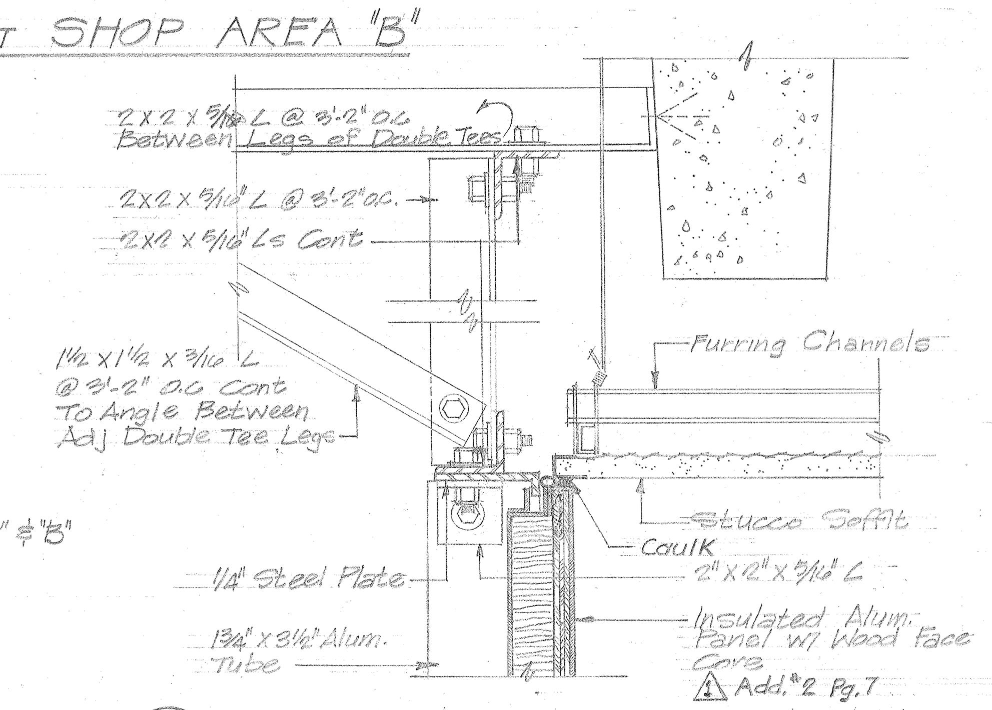

9 26|25 HEAD AT NORTH CONCOURSE
Scale: 3" = 1'-0"

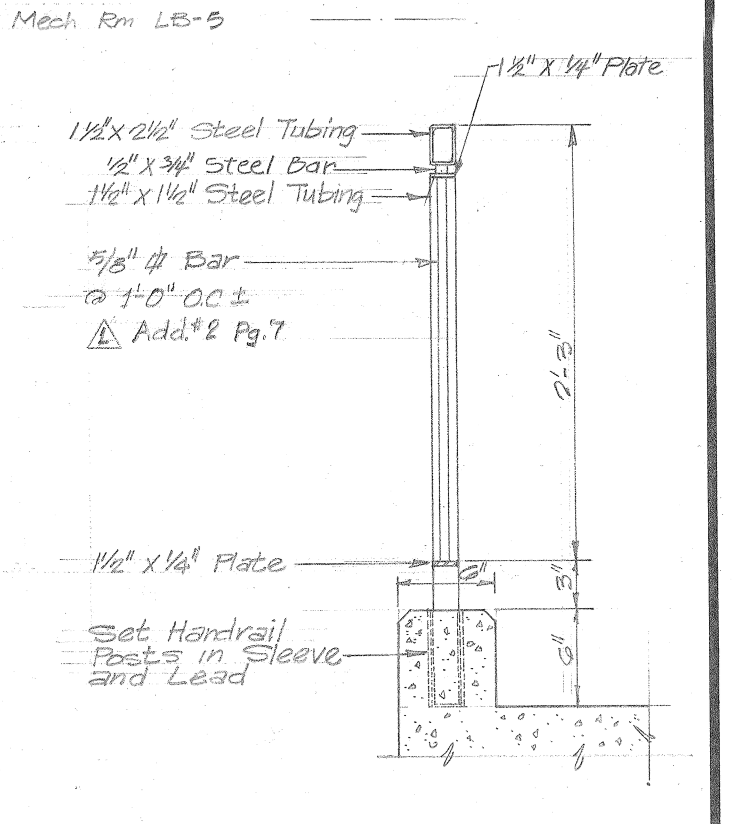

10 25|25 HANDRAIL SECTION
Scale: 1½" = 1'-0"

FRANKFURT · SHORT · EMERY · McKINLEY **ARCHITECTS · ENGINEERS**

MEMBER AMERICAN INSTITUTE OF ARCHITECTS


MEMBER AMERICAN SOCIETY OF HEATING, REFRIGERATING AND AIR CONDITIONING ENGINEERS

REVISION	DESCRIPTION	DATE
1	Added Addenda Items	1 Mar. 74
2	As Built Conditions	1 Mar. 74
3		
4		
5		
6		

KERR-McGEE CENTER
OKLAHOMA CITY OKLAHOMA


ELEVATIONS
PARKING AND
EXISTING BUILDINGS

COMM. NO. 36624
DATE 29 Sept 1969
SHEET NO. A-25

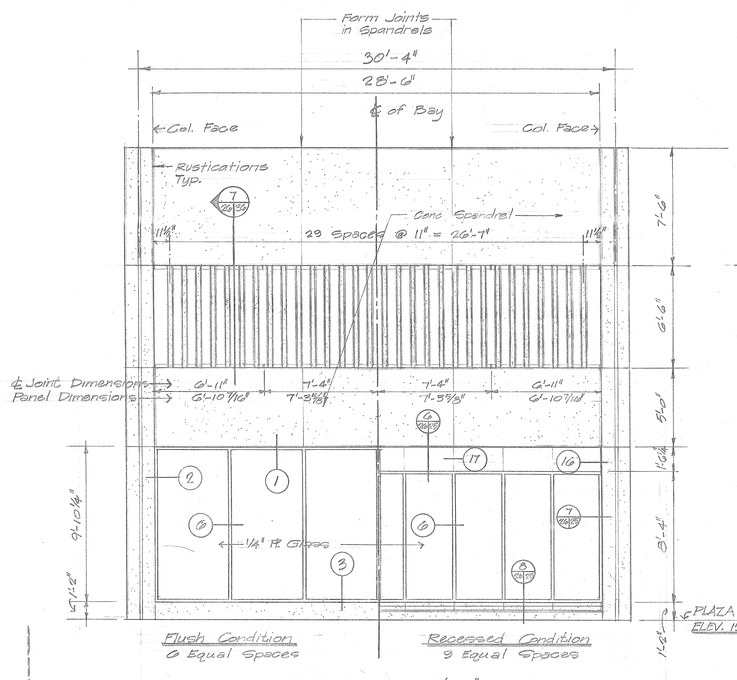


ELEVATION - TYPICAL 30'-4" BAY

Scale: 1/4" = 1'-0"

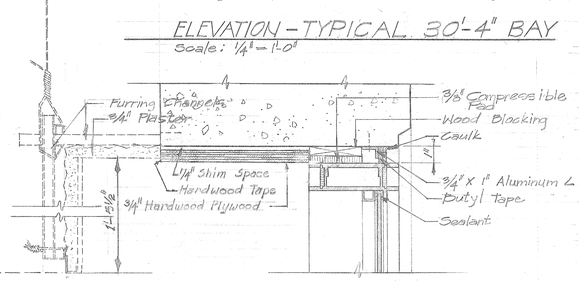


1 HEAD UNDER EXTERIOR SPANDREL


Add. 2 Pg. 7

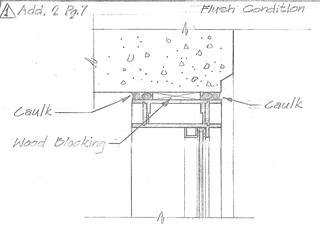

2 JAMB @ COLUMN

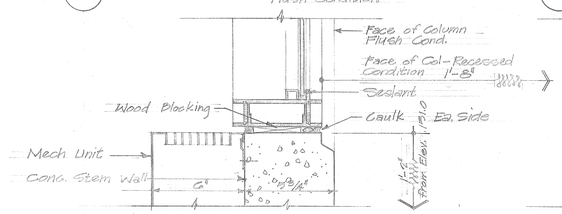


3 SILL AT STEM WALL

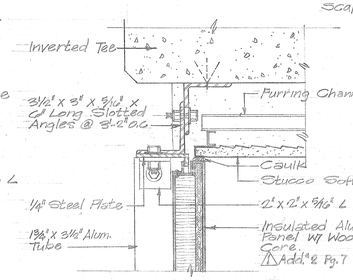


4 HEAD - ALUM. PANEL


Under Inverted Tee

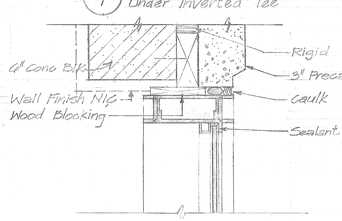

5 JAMB @ PRECAST PANEL

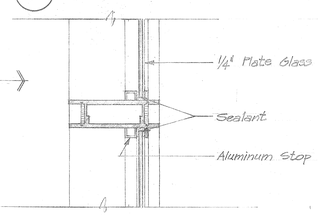


6 TYPICAL MULLION

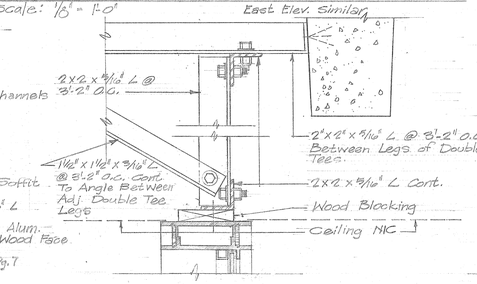


7 HEAD @ RESTAURANT ENTRY

Wing Walls — See Sht. #A-34

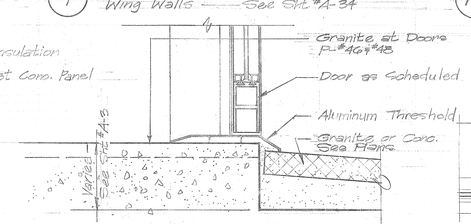


8 DOOR SILL - TYP.

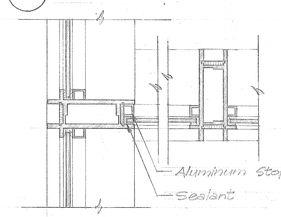


9 JAMB

Entry at Restaurant See Sht. #A-7

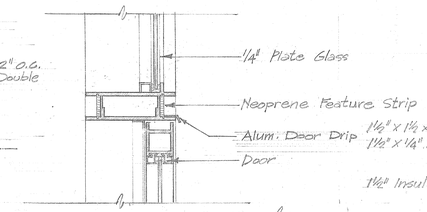


10 DOOR JAMB - TYP.

Head Similar

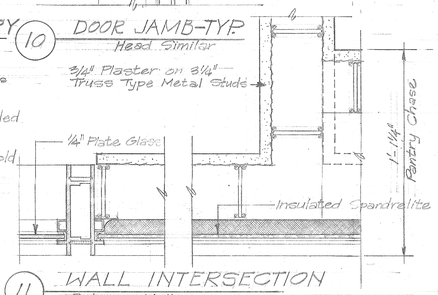

11 WALL INTERSECTION


Between Mulls See Shts. #A-7 & A-8

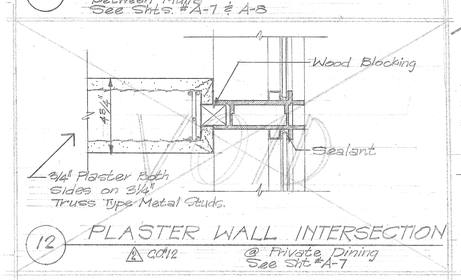


12 PLASTER WALL INTERSECTION

Add. 2 @ Private Dining See Sht. #A-7


13 HEAD MECH. LOUVER

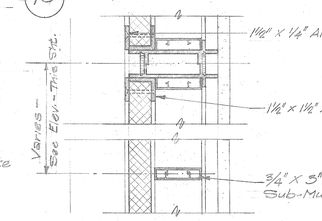


14 JAMB MECH. LOUVER

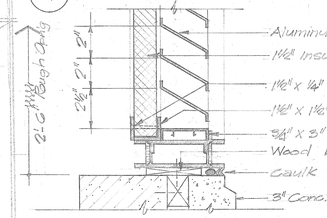


15 SILL MECH. LOUVER

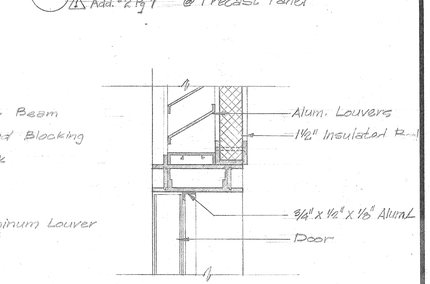


19 HEAD @ MECH. RM. DOOR

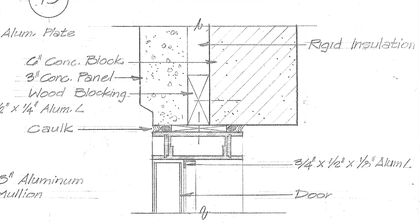


20 JAMB @ MECH. ROOM

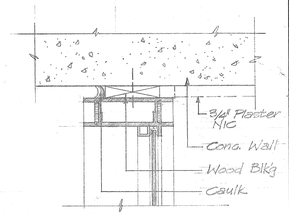


21 JAMB @ CONC. WALL

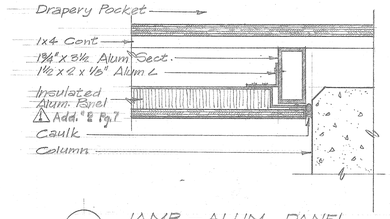

16 JAMB - ALUM. PANEL @ Column

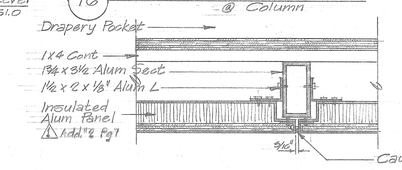

17 PANEL JOINT DETAIL

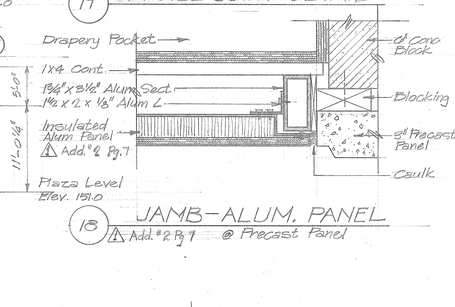


18 JAMB - ALUM. PANEL @ Precast Panel

Add. 2 Pg. 7


WEST ELEVATION OF NORTH CONCOURSE

Scale: 1/8" = 1'-0"

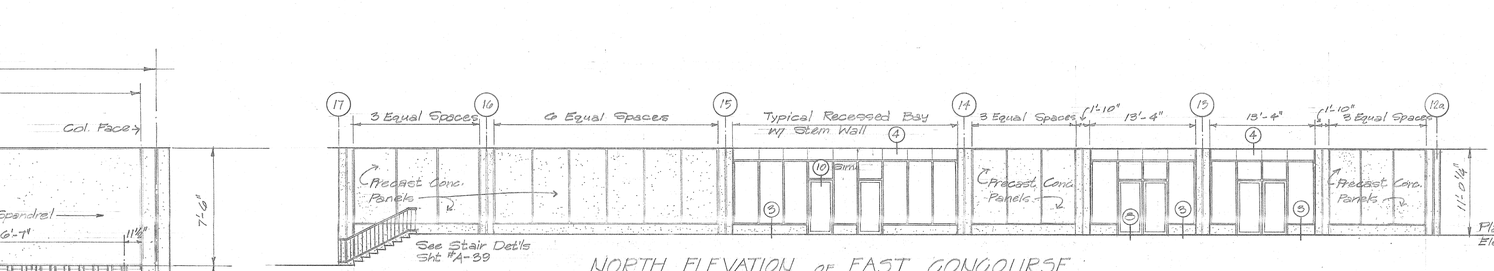


NORTH ELEVATION OF EAST CONCOURSE

Scale: 1/8" = 1'-0"

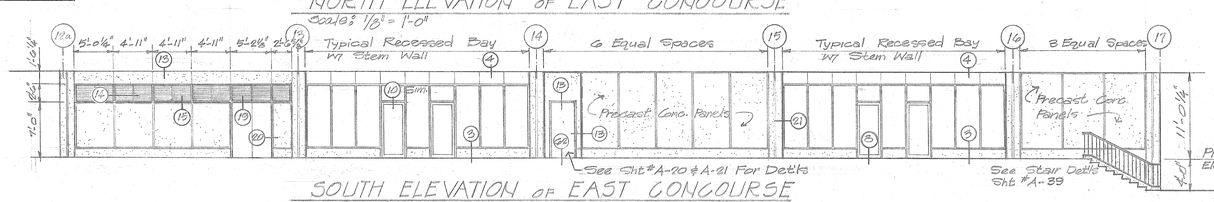

SOUTH ELEVATION OF EAST CONCOURSE

Scale: 1/8" = 1'-0"

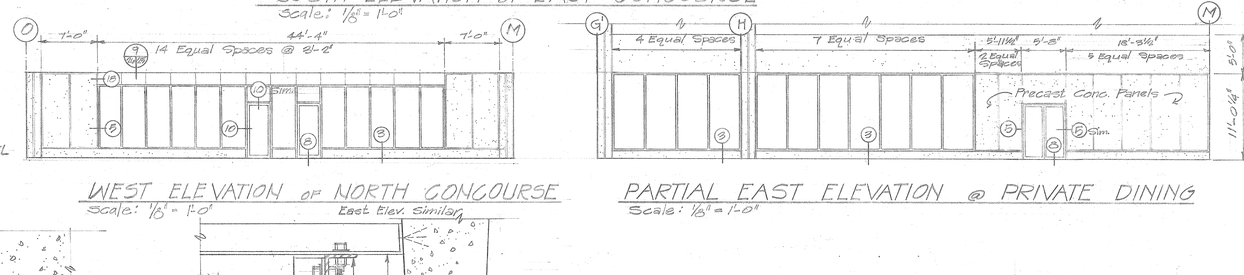

PARTIAL EAST ELEVATION @ PRIVATE DINING

Scale: 1/8" = 1'-0"

NOTE: All Details This Sheet Scale 3"=1'-0" Unless Otherwise Noted.

FRANKFURT · SHORT · EMERY · McKINLEY **ARCHITECTS · ENGINEERS**

FSEM

MEMBER AMERICAN INSTITUTE OF ARCHITECTS

MEMBER AMERICAN SOCIETY OF HEATING, REFRIGERATING AND AIR CONDITIONING ENGINEERS

REVISION	DESCRIPTION	DATE
1	Added Addenda Items	1 Mar. 74
2	As Built Conditions	1 Mar. 74
3		
4		
5		
6		


KERR-McGEE CENTER
OKLAHOMA CITY OKLAHOMA

COMM. NO. 3660.24


DATE 29 Sept 1969

SHEET NO. A


ELEVATIONS
SHOPS

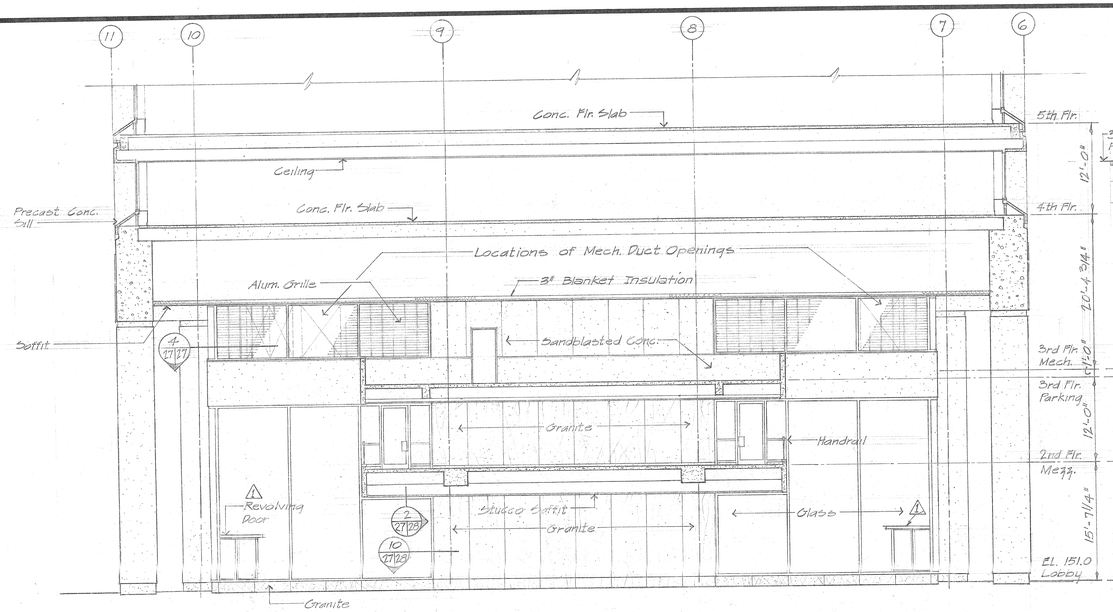


NORTH ELEVATION OF TOWER LOBBY
Scale: 1/8" = 1'-0"

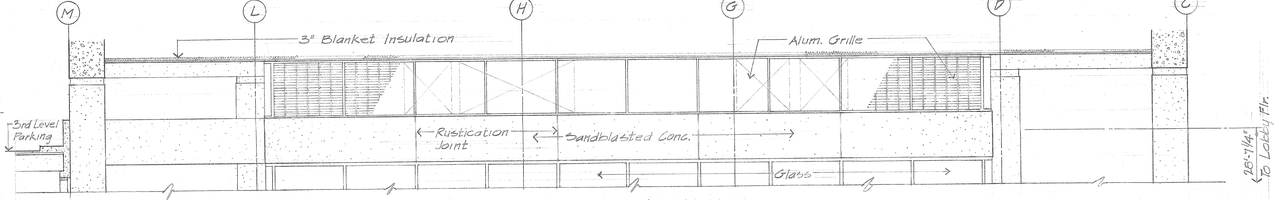


WEST ELEV. OF GRILLE/LOUVER

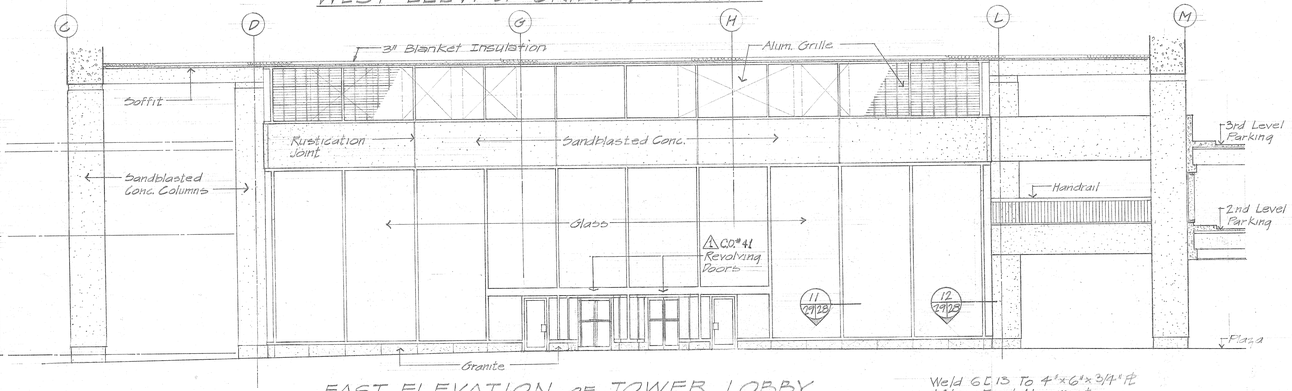


EAST ELEVATION OF TOWER LOBBY
Scale: 1/8" = 1'-0"

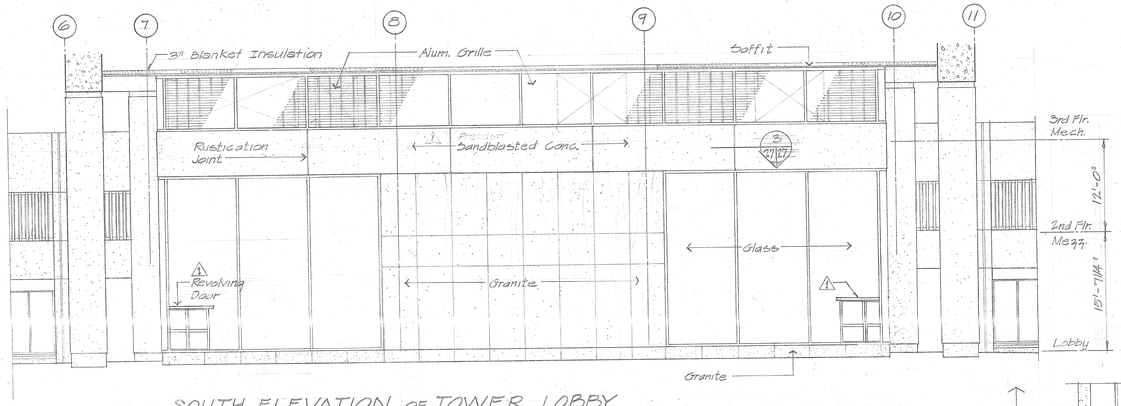

SOUTH ELEVATION OF TOWER LOBBY
Scale: 1/8" = 1'-0"

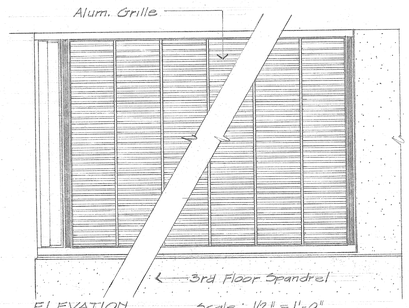


ELEVATION
MECHANICAL LOUVER GRILLE
Scale: 1/2" = 1'-0"

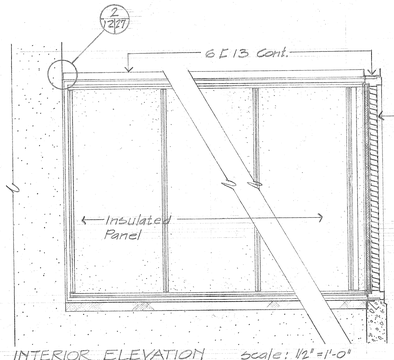


INTERIOR ELEVATION
MECHANICAL LOUVER GRILLE
Scale: 1/2" = 1'-0"


NOTE:
Dashed Support Indicates Relationship of Support to Panel. This Applies Only To Supports At The East & West Walls. For All Support Locations See Sht's A-12 & A-8

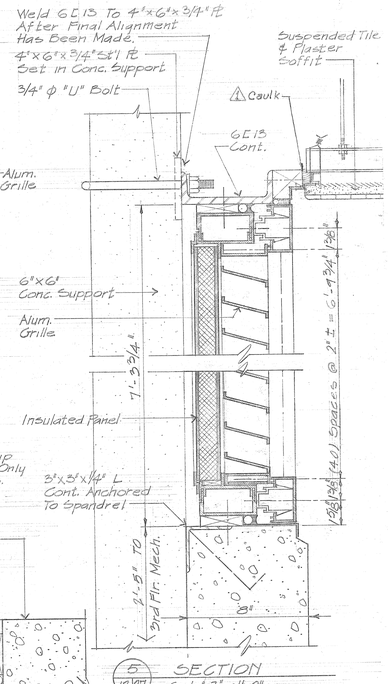


SECTION
Scale: 3" = 1'-0"

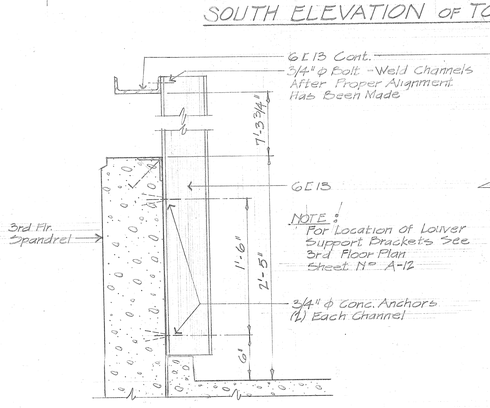


1/12/27 LOUVER SUPPORT BRACKET
Scale: 1½" = 1'-0"

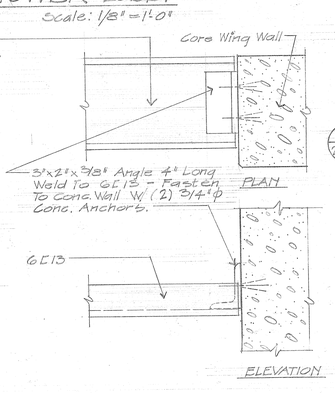

2/27/27 CHANNEL CONNECTION
Scale: 3" = 1'-0"

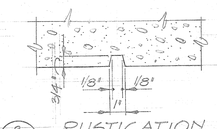

3/27/27 RUSTICATION JOINT
Scale: 3" = 1'-0"

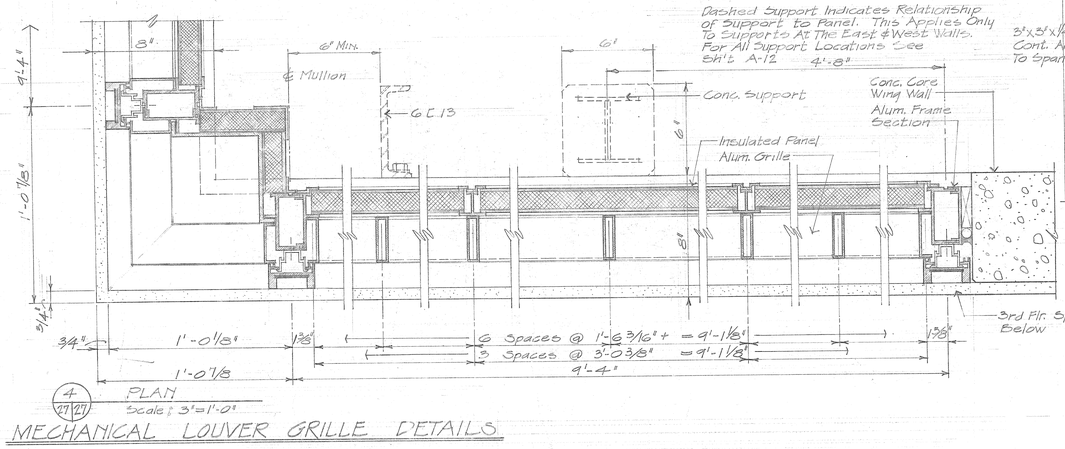

4/27/27 PLAN
Scale: 3" = 1'-0"

MECHANICAL LOUVER GRILLE DETAILS

REVISION	DESCRIPTION	DATE
1	As Built Condition	1 Mar. 74
2		
3		
4		
5		
6		

KERR-McGEE CENTER
OKLAHOMA CITY OKLAHOMA


ELEVATIONS
ENTRANCE AND DETAILS

COMM. NO. 366024
DATE 29 Sept. 1969
SHEET NO. A-27

FSEM

FRANKFURT · SHORT · EMERY · McKINLEY
MEMBER AMERICAN INSTITUTE OF ARCHITECTS

ARCHITECTS · ENGINEERS
MEMBER AMERICAN SOCIETY OF HEATING, REFRIGERATING AND AIR CONDITIONING ENGINEERS

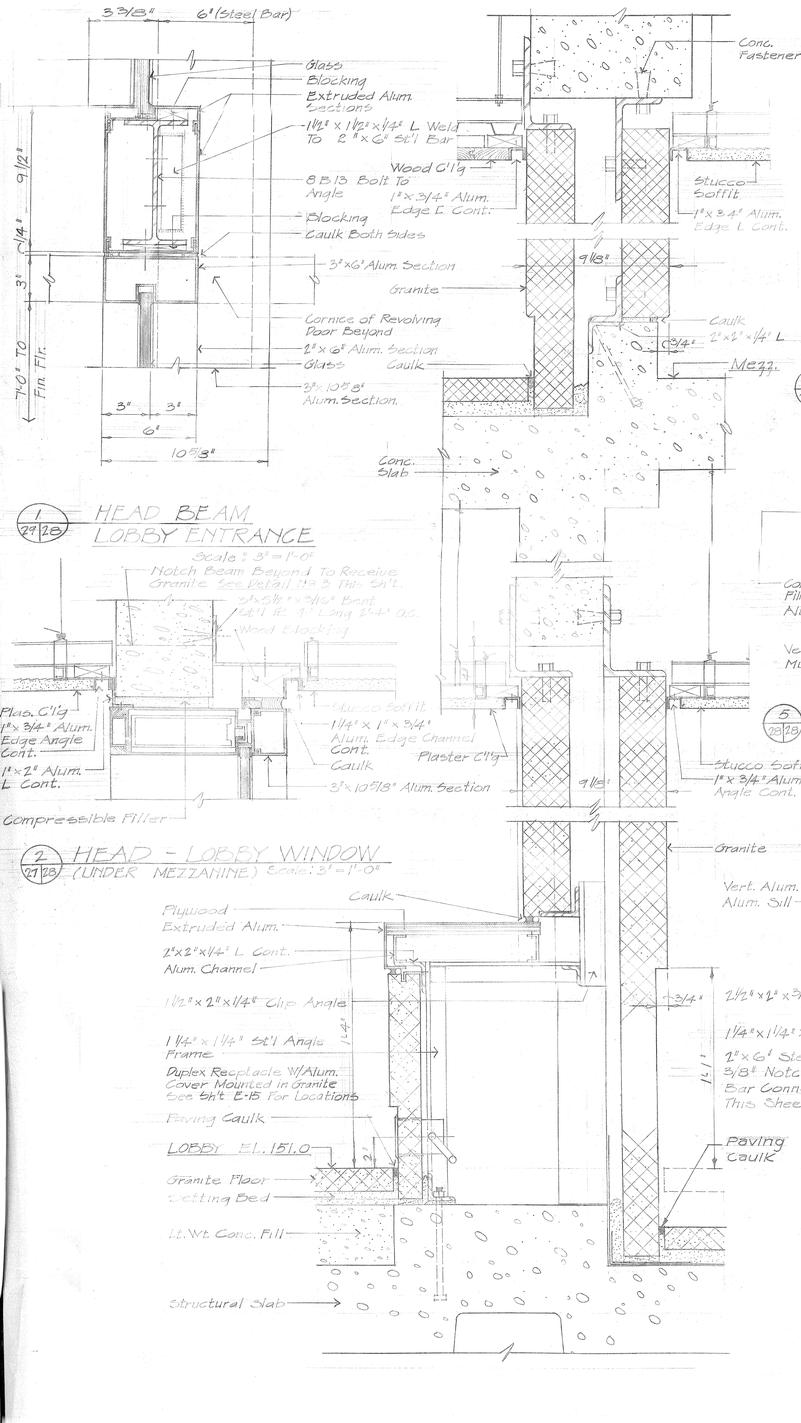

1 / 27/28 HEAD BEAM LOBBY ENTRANCE
Scale: 3" = 1'-0"

Notch Beam Beyond To Receive Granite See Detail 1 & 3 This Sht.

2 / 27/28 HEAD - LOBBY WINDOW (UNDER MEZZANINE) Scale: 3" = 1'-0"

4 / 28/28 PLAN - SECTION of WINDOW BASE - AIR SUPPLY
Scale: 3/4" = 1'-0"

5 / 28/28 SECTION - VERT. MULLION SUPPORT AT HEAD - LOBBY
Scale: 3" = 1'-0"

STEEL BAR CONNECTION DETAIL

9 / 11/28 HEAD - LOBBY WINDOW
Scale: 3" = 1'-0"

10 / 27/28 JAMB AT TOWER CORE WING WALL

11 / 27/28 VERT. MULLION - TYPICAL

12 / 27/28 CORNER - TYPICAL

3 / 27/28 SECTION AT NORTH WING WALL & LOBBY WINDOW BASE EXTENSION
Scale: 3" = 1'-0"

6 / 28/28 SECTION - VERT. MULLION SUPPORT AT WINDOW BASE
Scale: 3" = 1'-0"

8 / 11/28 SECTION - LOBBY WINDOW BASE - AIR SUPPLY
Scale: 3" = 1'-0"

DETAILED PLAN of LOBBY WINDOW BASE - AIR SUPPLY
Scale: 3" = 1'-0"

FSEM

FRANKFURT · SHORT · EMERY · McKINLEY **ARCHITECTS · ENGINEERS**

MEMBER AMERICAN INSTITUTE OF ARCHITECTS


MEMBER AMERICAN SOCIETY OF HEATING, REFRIGERATING AND AIR CONDITIONING ENGINEERS


REVISION	DESCRIPTION	DATE
1	As Built Conditions	1 Mar. 74
2		
3		
4		
5		
6		

KERR-McGEE CENTER
OKLAHOMA CITY, OKLAHOMA


LOBBY DETAILS TOWER

COMM. NO. 366.24
DATE 29 Sept 1969
SHEET NO. A-28

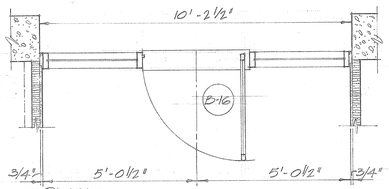


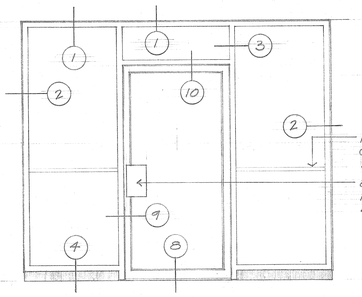


ENTRY - WEST WALL of ELEV. LOBBY B-16 (B-22 OPP. HAND)
Scale: ½"=1'-0"

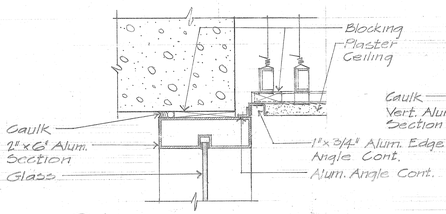


1 HEAD
Scale: 3"=1'-0"

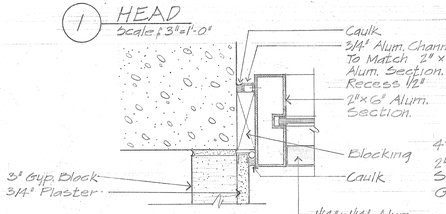


2 JAMB
Scale: 3"=1'-0"

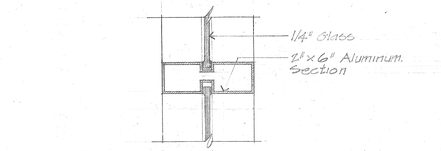


3 MULLION (VERT.)
Scale: 3"=1'-0"

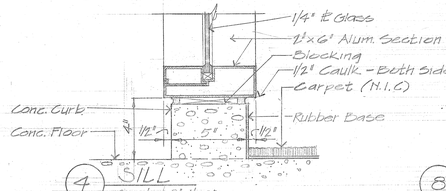


4 SILL
Scale: 3"=1'-0"

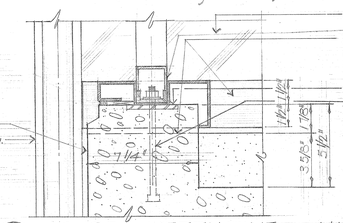


5 / 19 / 29 CURB - MEZZANINE @ HANDRAIL
Scale: 3"=1'-0"

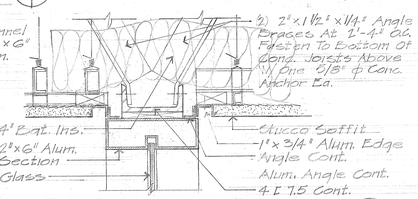

6 HEAD
Scale: 3"=1'-0"

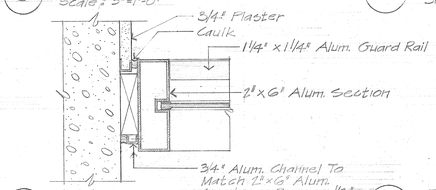


7 JAMB
Scale: 3"=1'-0"

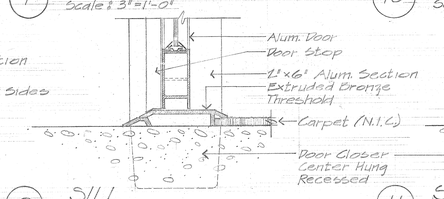


8 SILL
Scale: 3"=1'-0"


ELEVATION
ENTRY - EAST WALL of CORRIDOR B-20 (Looking West)
Scale: ½"=1'-0"

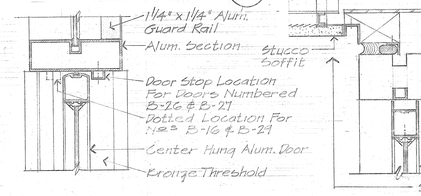


9 JAMB
Scale: 3"=1'-0"

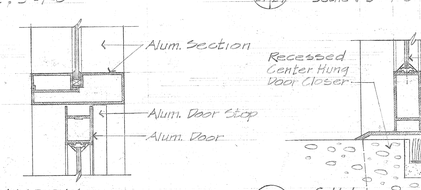


10 TRANSOM
Scale: 3"=1'-0"

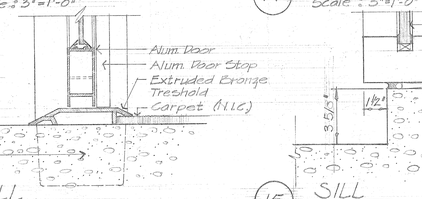

11 SILL
Scale: 3"=1'-0"

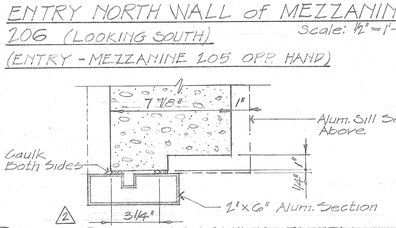


12 CURB - MEZZANINE ENTRY

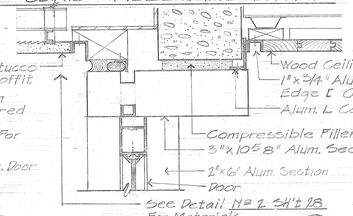


13 / 29 / 29 HEAD
Scale: 3"=1'-0"


14 SILL
Scale: 3"=1'-0"

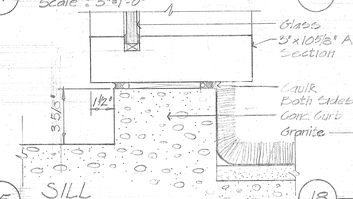


15 SILL
Scale: 3"=1'-0"

ELEVATION
ENTRY NORTH WALL of MEZZANINE 206 (LOOKING SOUTH)
Scale: ½"=1'-0"
(ENTRY - MEZZANINE 205 OPP. HAND)

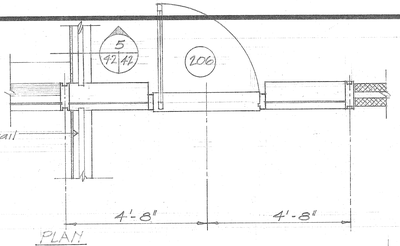


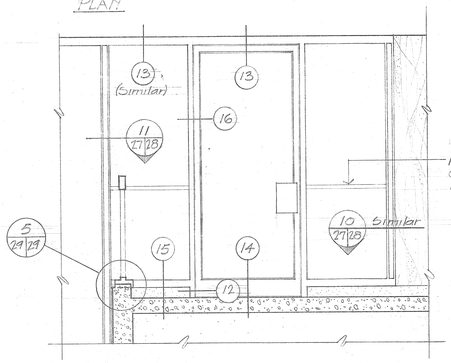


16 JAMB
Scale: 3"=1'-0"

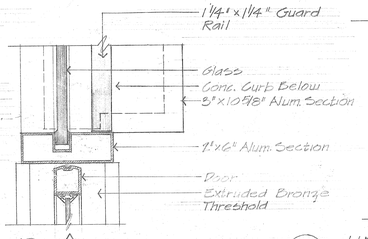



17 JAMB
Scale: 3"=1'-0"

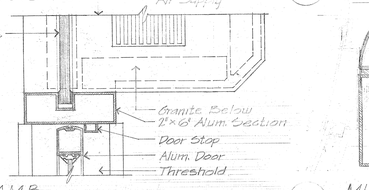


18 SILL
Scale: 3"=1'-0"

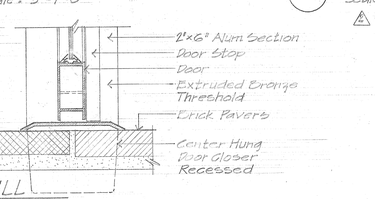

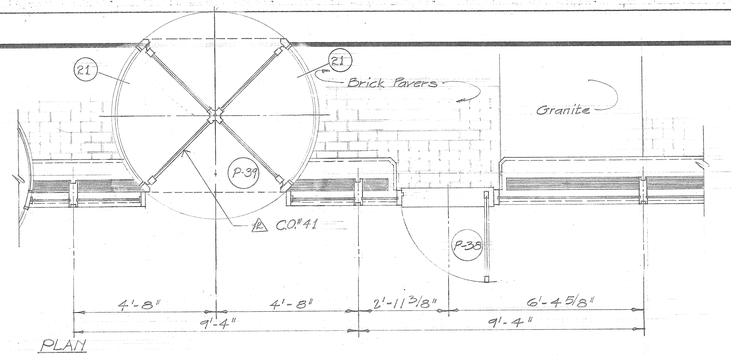


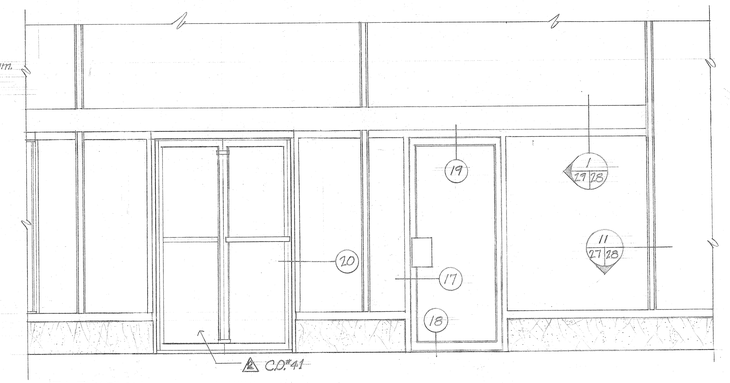


ELEVATION
EAST ENTRY of TOWER LOBBY (RIGHT HALF SHOWN)
(LEFT HALF OPP. HAND)
(WEST ENTRY of TOWER LOBBY SIMILAR)
Scale: ½"=1'-0"

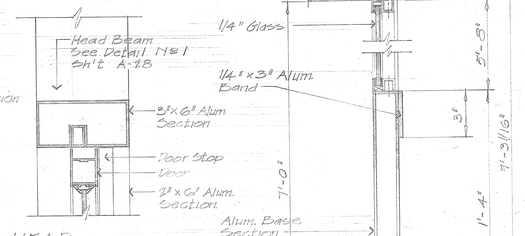

19 HEAD
Scale: 3"=1'-0"

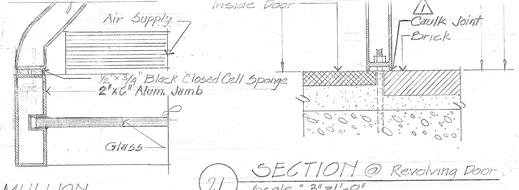

20 MULLION
Scale: 3"=1'-0"
C.O. #41, Shop Drwg #250

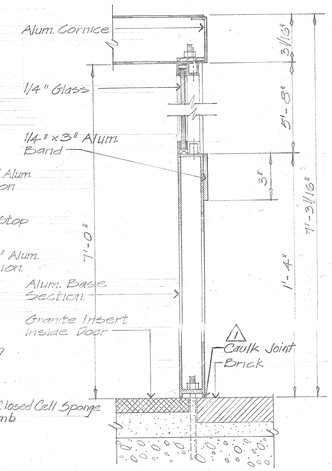

21 SECTION @ Revolving Door
Scale: 3"=1'-0"
Add. #2 Pg. 7

FSEM

FRANKFURT · SHORT · EMERY · McKINLEY **ARCHITECTS · ENGINEERS**

MEMBER AMERICAN INSTITUTE OF ARCHITECTS


MEMBER AMERICAN SOCIETY OF HEATING, REFRIGERATING AND AIR CONDITIONING ENGINEERS


REVISION	DESCRIPTION	DATE
1	Added Addenda Items	1 Mar. 74
2	As Built Conditions	1 Mar. 74
3		
4		
5		
6		

KERR-McGEE CENTER
OKLAHOMA CITY, OKLAHOMA


LOBBY DETAILS TOWER

COMM. NO. 366624
DATE 29 Sept. 1969
SHEET NO. A-29

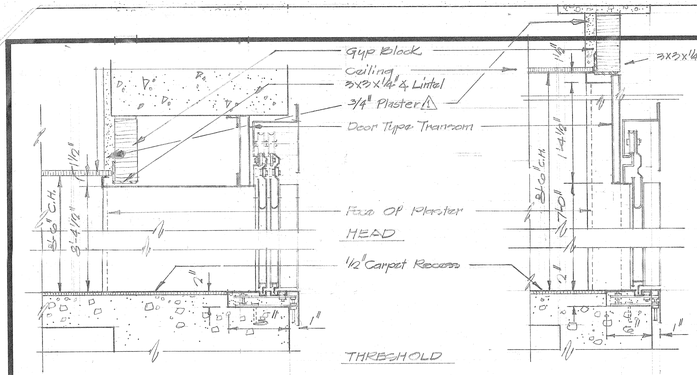

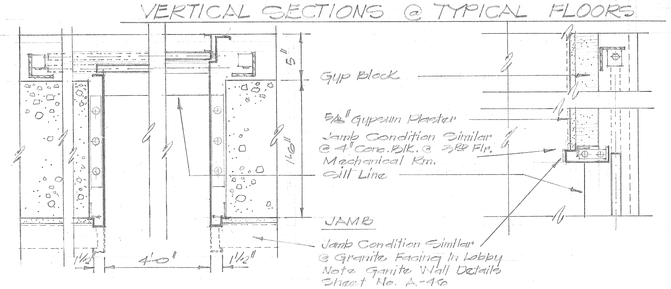


VERTICAL SECTIONS @ TYPICAL FLOORS

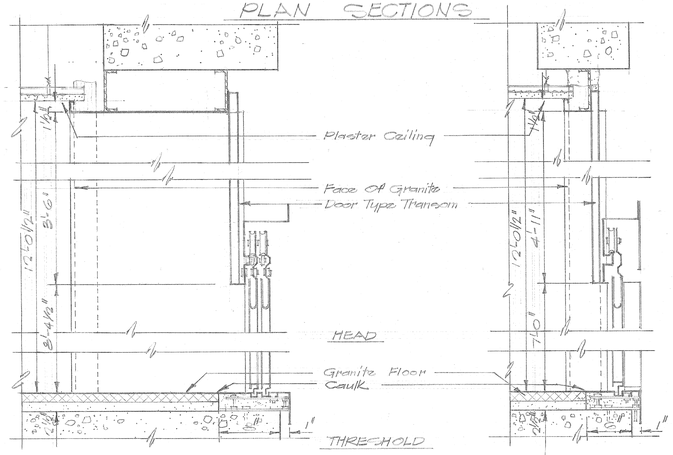

PLAN SECTIONS


VERT. SECTIONS @ PLAZA ⚠1 Add'd Pg.1
SERVICE ELEVATOR Scale 1½"=1'0" PASSENGER ELEVATORS

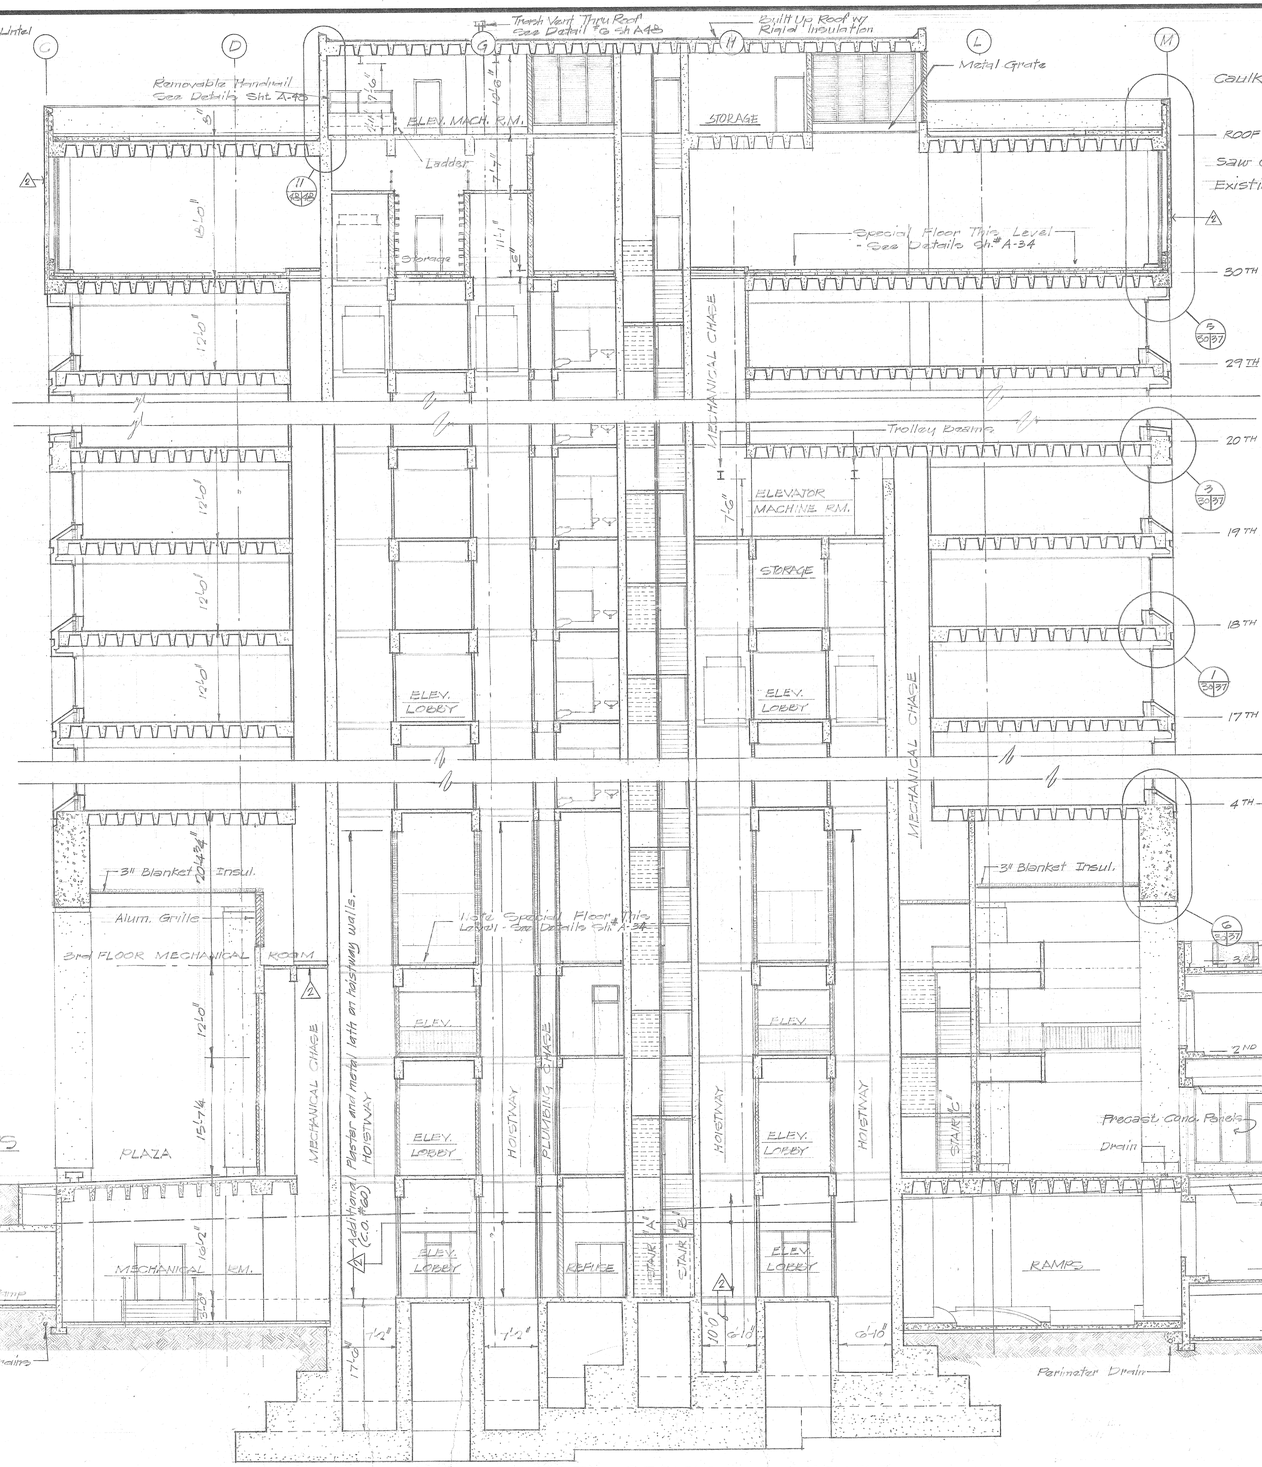


⚠2 See Sheet A-10 For Plaza Details

SOUTH-NORTH SECTION THRU TOWER

1/3|30 ⚠1 Add'd Pg.1 ⚠2 C.O. '75, '77 Scale: 1/8"=1'-0"

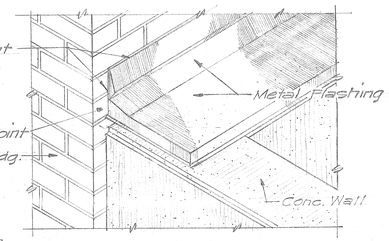

2|31|30 FLASHING DETAIL
Scale: 1½"=1'-0"

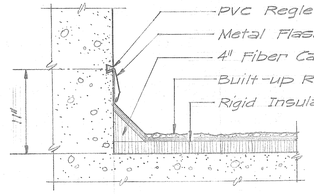

3|10|30 FLASHING DETAIL
Scale: 1½"=1'-0"

⚠2 NOTE:
All Precast DBL. Tees Are 8'-0" O.C. W/ 32" Depth.

FSEM

FRANKFURT · SHORT · EMERY · McKINLEY **ARCHITECTS · ENGINEERS**

MEMBER AMERICAN INSTITUTE OF ARCHITECTS


MEMBER AMERICAN SOCIETY OF HEATING, REFRIGERATING AND AIR CONDITIONING ENGINEERS

REVISION	DESCRIPTION	DATE
1	Added Addenda Items	1 May 74
2	As Built Conditions	1 May 74
3		
4		
5		
6		

KERR-McGEE CENTER
OKLAHOMA CITY, OKLAHOMA

SOUTH-NORTH SECTION TOWER


COMM. NO. 3666.24
DATE 27 Sept. 1968
SHEET NO. A-30

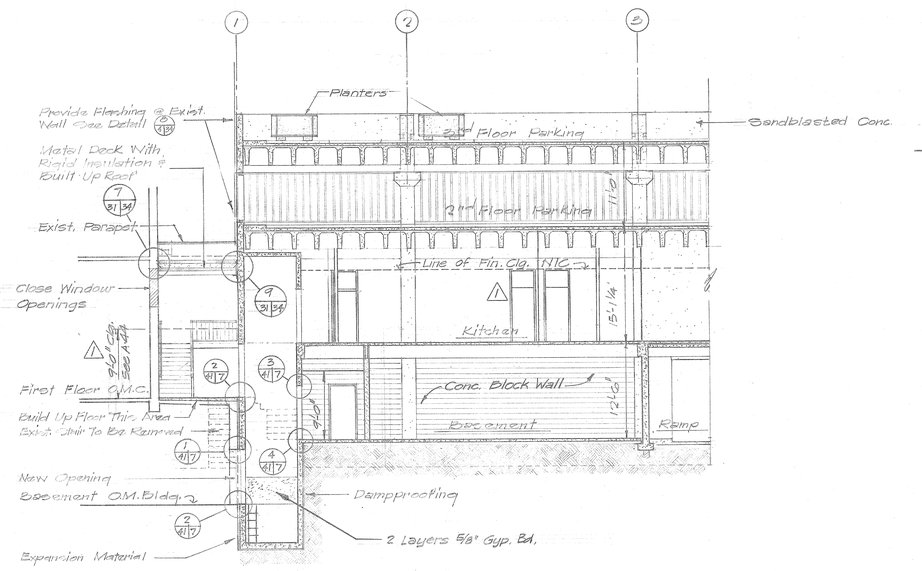

1 Add. #2, p.7

1/3/31 WEST - EAST SECTION THRU FREIGHT ELEVATOR #11


Scale: 1/8" = 1'-0" Looking North

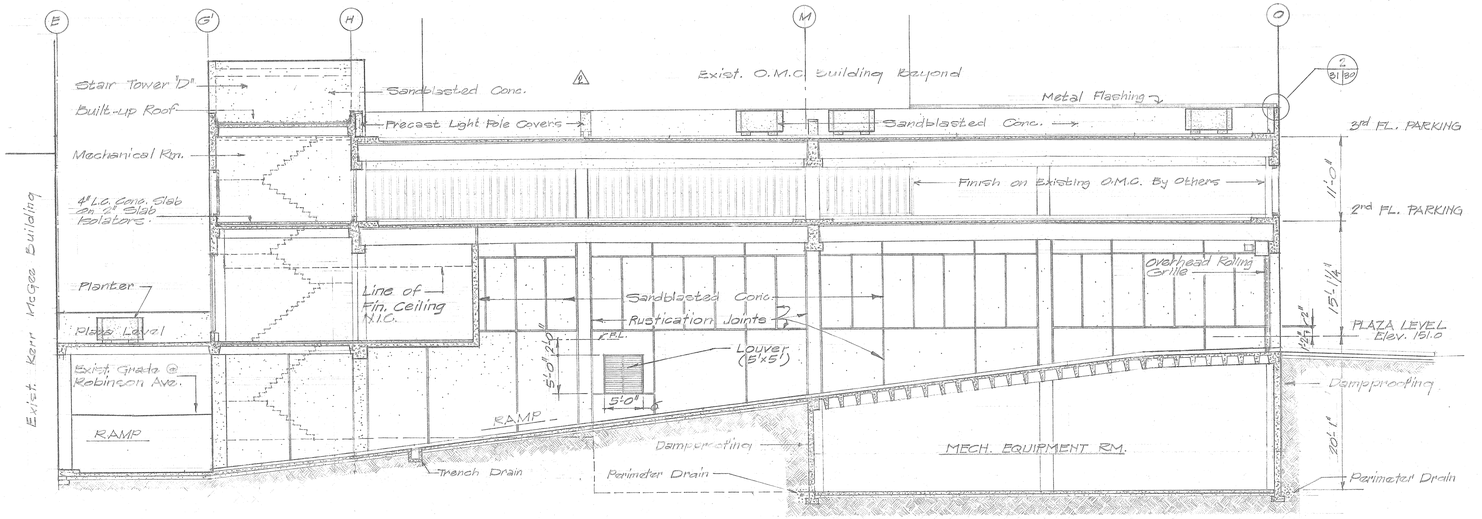

1 Revised Rustications as Requested - Opposite Wall Similar

2/3/31 SOUTH-NORTH SECTION THRU PARKING LEVELS AT WEST RAMP

Scale: 1/8" = 1'-0" Looking West

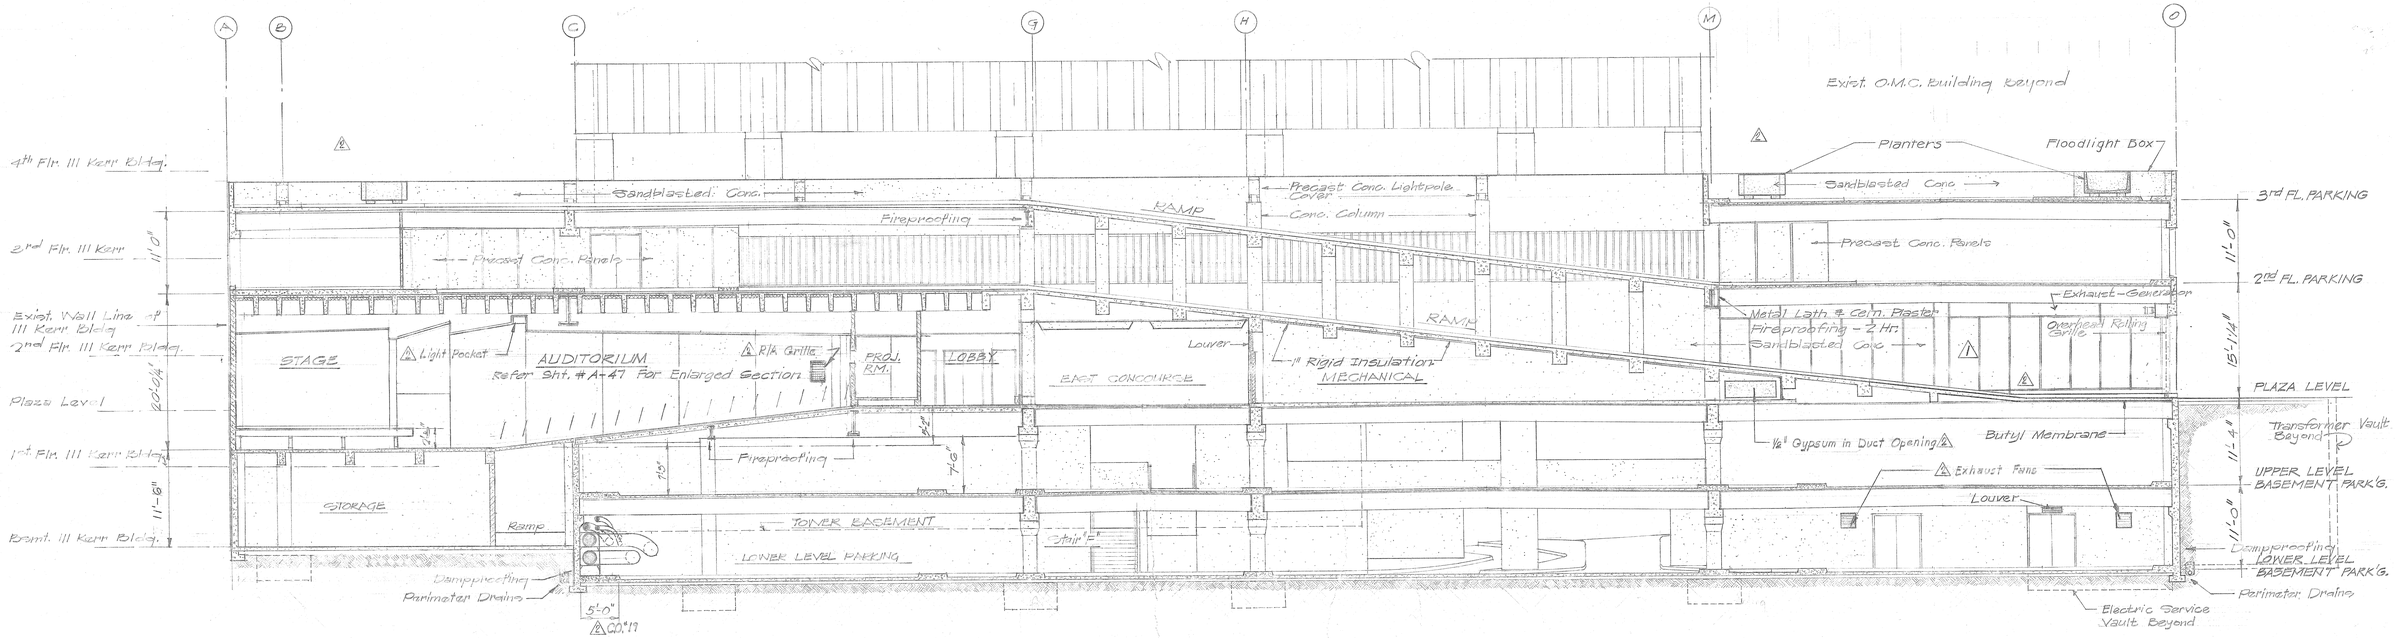

NOTE: All Precast DBL. Tees Are 8'-0" O.C. w/ 32" Depth.

1 Added Rustications to Entrance Walls of East Ramp

3/3/31 SOUTH-NORTH SECTION THRU PARKING LEVELS AT EAST RAMPS

Scale: 1/8" = 1'-0" Looking West

1 Lights Are Omitted on 3rd Floor Parking, Alcove Omitted Plaza Level

FRANKFURT · SHORT · EMERY · McKINLEY ARCHITECTS · ENGINEERS

FSEM

MEMBER AMERICAN INSTITUTE OF ARCHITECTS

MEMBER AMERICAN SOCIETY OF HEATING, REFRIGERATING AND AIR-CONDITIONING ENGINEERS

REVISION	DESCRIPTION	DATE
1	Added Addenda Items - Revised Rustications, Louvre as Requested at Each 3rd Floor Parking	28 APR. 70
2	As Built Conditions	1 MAY. 74
3		
4		
5		
6		


KERR-McGEE CENTER OKLAHOMA CITY, OKLAHOMA

SECTIONS RAMPS AND AUDITORIUM

COMM. NO. 3666.24

DATE 29 Sept. 1969

SHEET NO. A-31

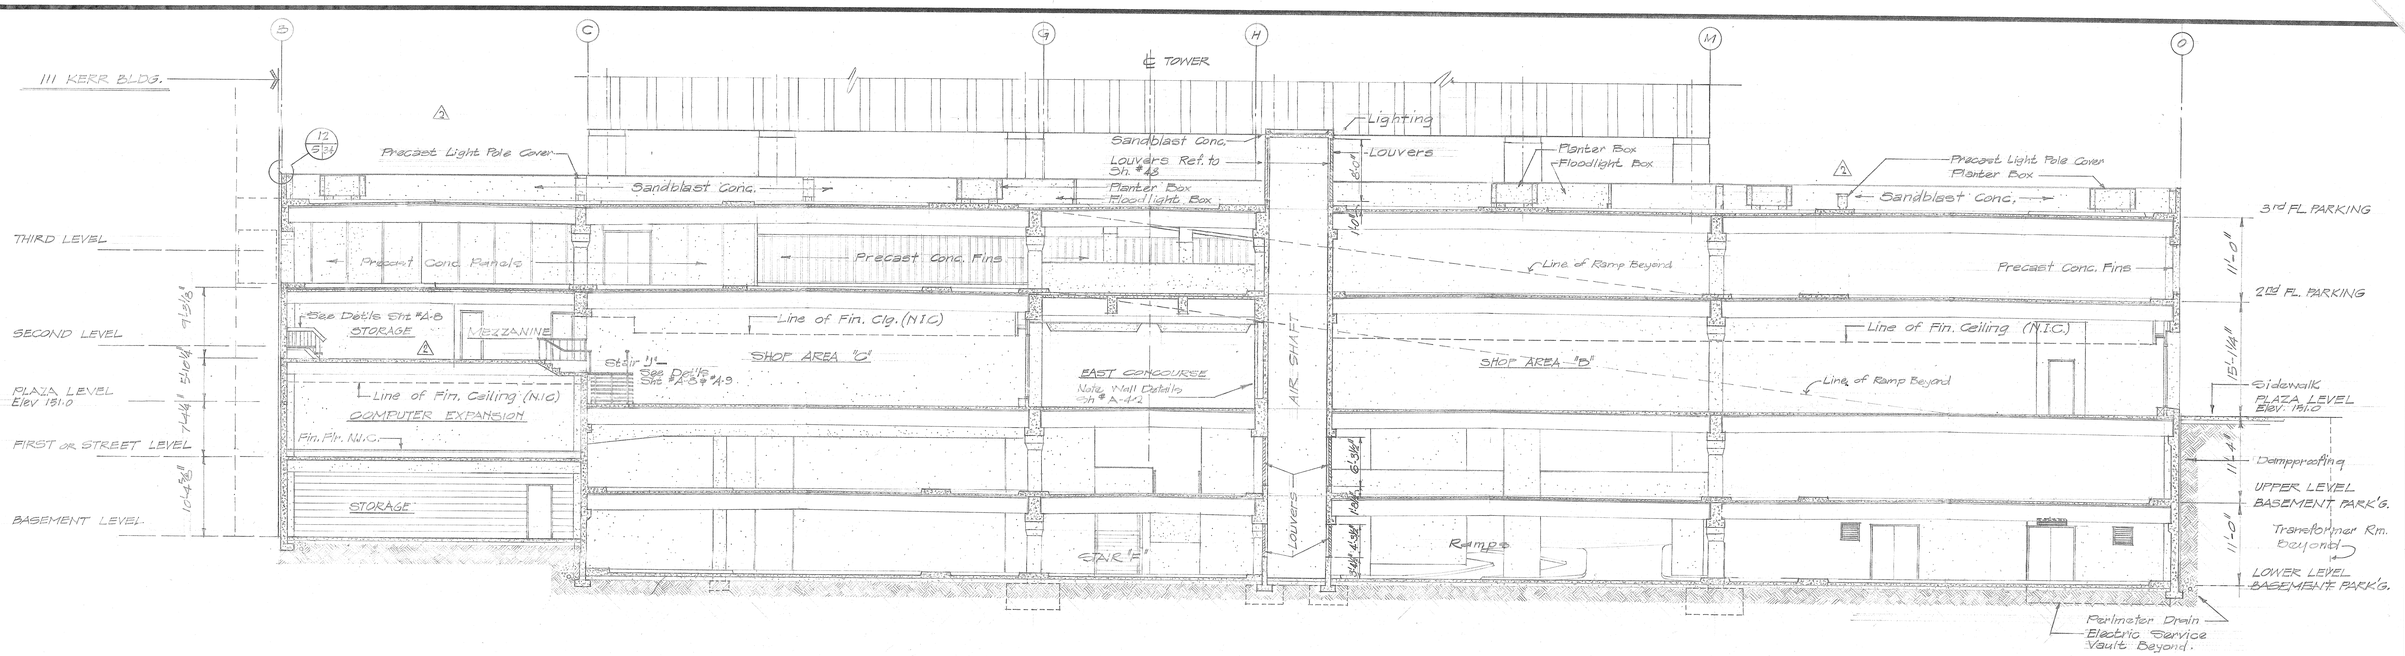



Omit Wall Between Storage & Mezzanine (CO.#43); Omit Pole Lights 3rd Flr. Parking

1/3/32 SOUTH-NORTH SECTION THRU SHOPS AND PARKING LEVELS

Scale: 1/8"=1'-0"

LOOKING WEST

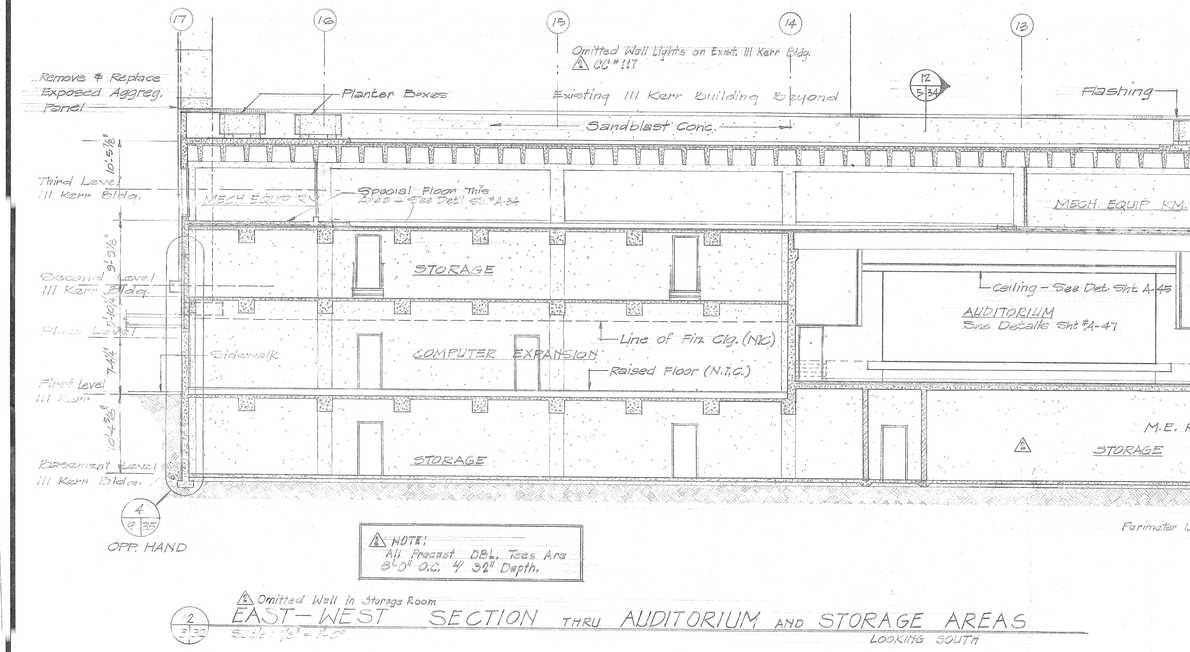

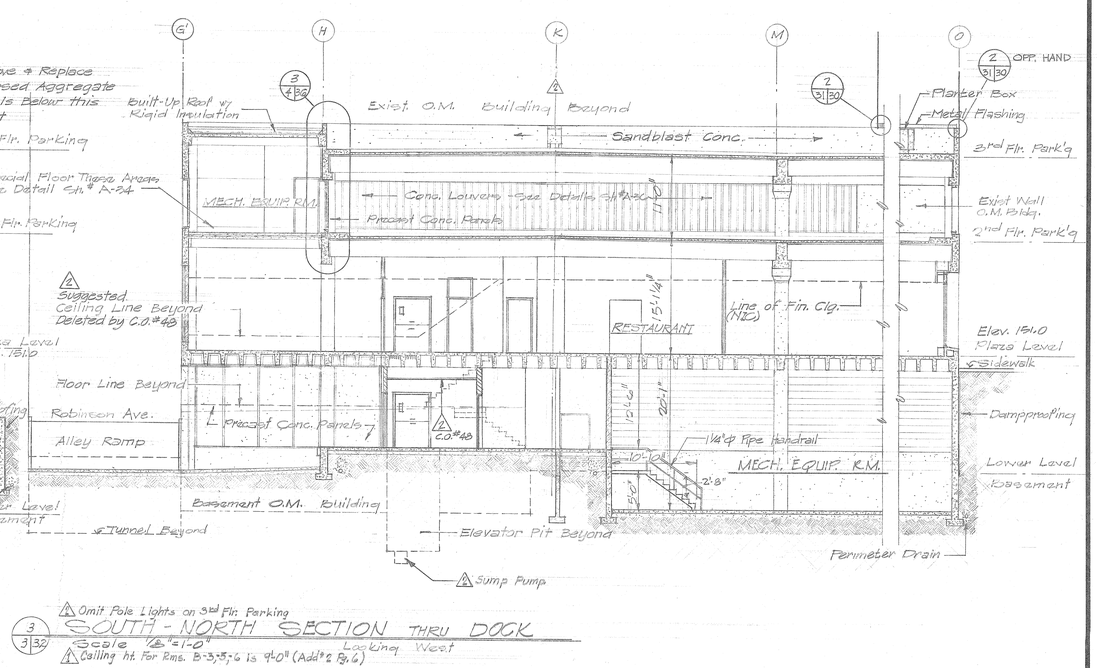


FRANKFURT · SHORT · EMERY · McKINLEY
ARCHITECTS · ENGINEERS
MEMBER AMERICAN INSTITUTE OF ARCHITECTS
MEMBER AMERICAN SOCIETY OF HEATING, REFRIGERATING AND AIR CONDITIONING ENGINEERS
FSEM

REVISION	DESCRIPTION	DATE
1	Added Appendix & Addenda Items	1 Mar. 74
2	As Built Conditions	1 Mar. 74
3		
4		
5		
6		

KERR-McGEE CENTER
OKLAHOMA CITY OKLAHOMA
SECTIONS

COMM. NO. 3666.24
DATE 29 Sept. 1969
SHEET NO. A-32

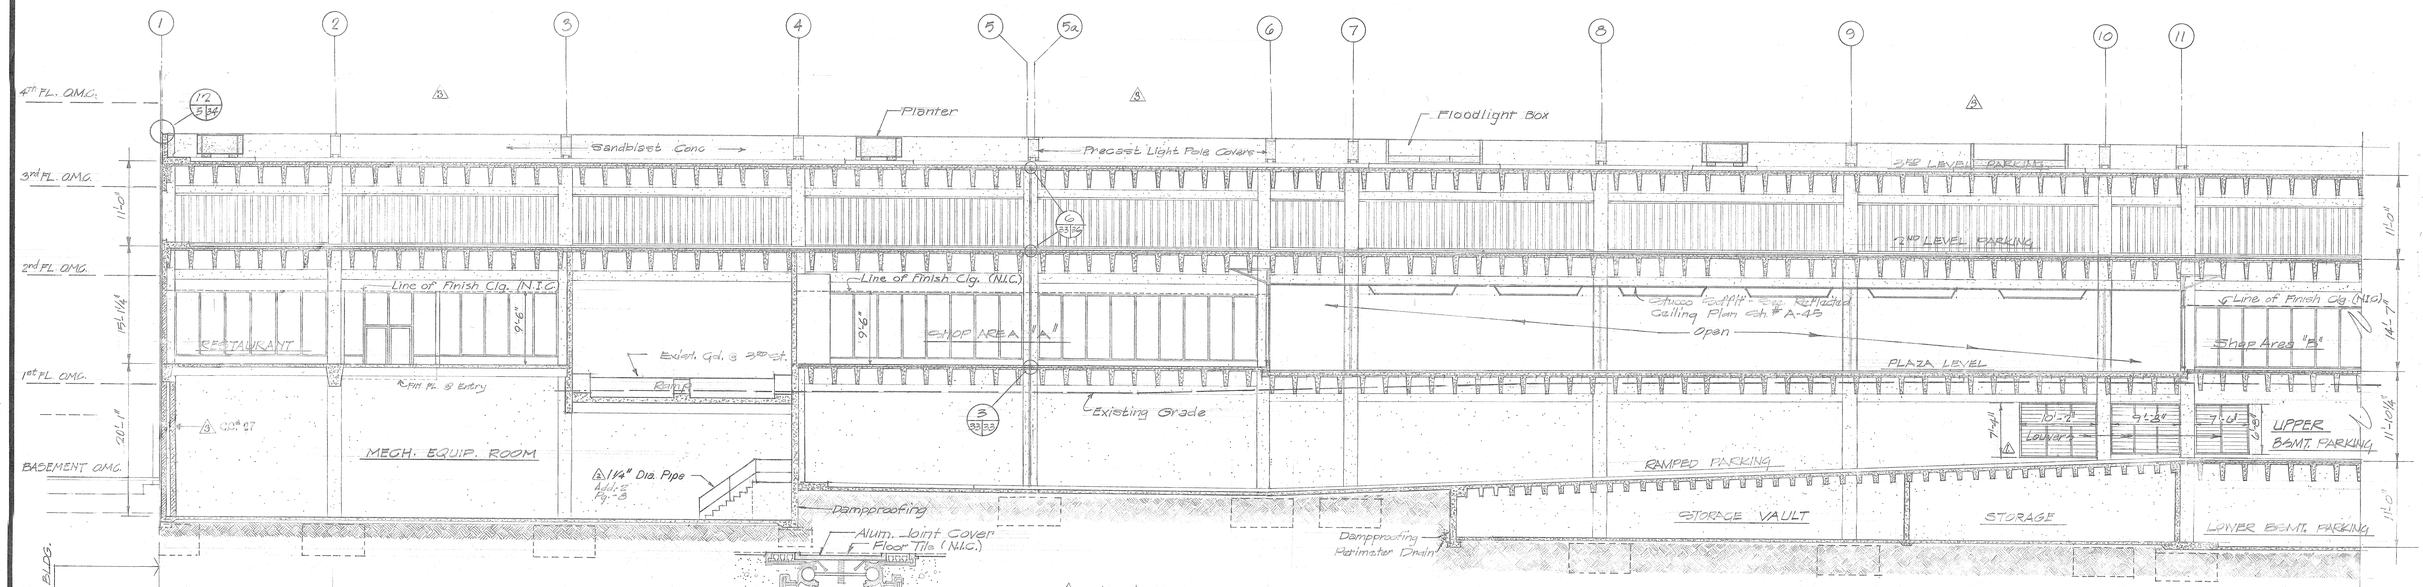

FRANKFURT · SHORT · EMERY · McKINLEY — **ARCHITECTS · ENGINEERS**

FSEM

MEMBER AMERICAN INSTITUTE OF ARCHITECTS

MEMBER AMERICAN SOCIETY OF HEATING, REFRIGERATING AND AIR CONDITIONING ENGINEERS

REVISION	DESCRIPTION	DATE
1	Relocation of Transformer Vault Louvers	6 July 70
2	Addendums noted - General Revisions	1 Mar. 74
3	As Built Condition	1 May 74
4		
5		
6		


KERR-McGEE CENTER
OKLAHOMA CITY, OKLAHOMA

WEST-EAST SECTIONS

COMM. NO. 366.24

DATE 29 Sept 1969

SHEET NO. A-33

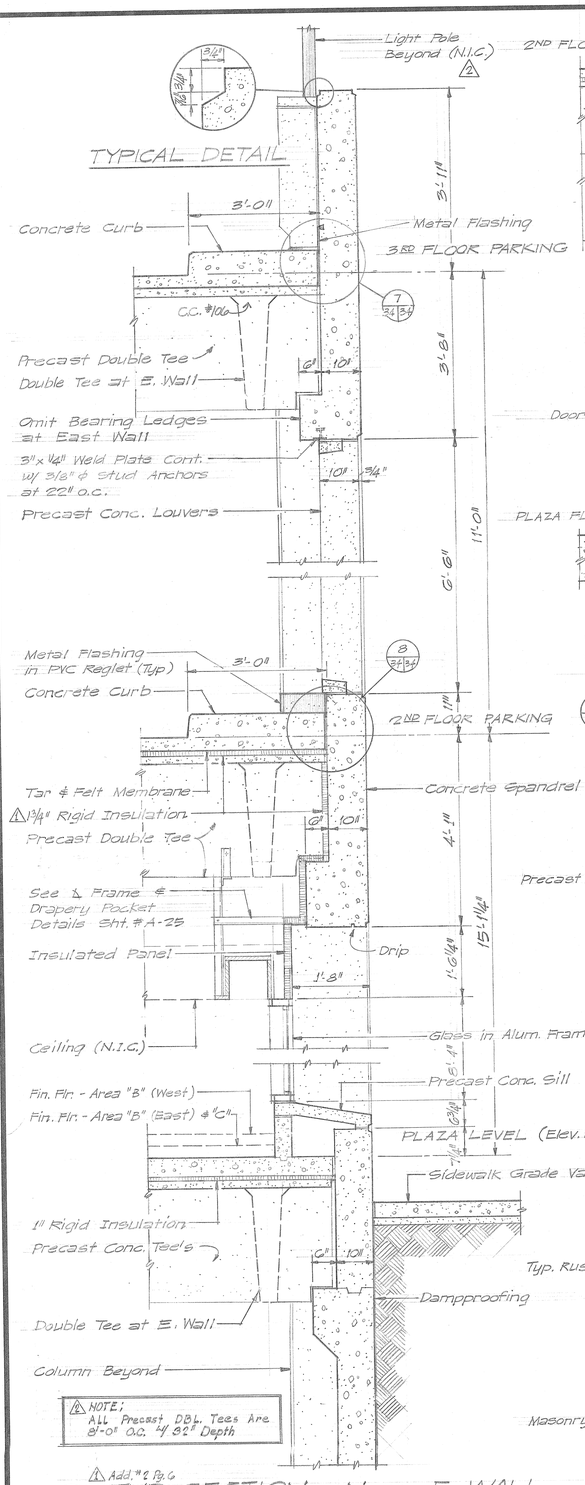

1 TYP. SECTION - N. OR E. WALL
Scale: 3/4" = 1'-0" PARKING STRUCTURE

△ Add. #2 Pg. 6

2 S. WALL SECTION
Scale: 3/4" = 1'-0" RM. # B-8

3 SECTION THRU N. ENTRANCE
Scale: 1/2" = 1'-0" DINING RM. # P-2

8 PLAN DETAIL

10 ROOF DETAIL

12 WALL DETAIL

14 WALL DETAIL

16 WALL DETAIL
N. E. CORNER - 111 KERR

Note: 1. Stucco Projection to be cut back to 2" From E. Face of Column & Patched as Required For Finished Appearance
2. All Rigid Insulation This Sheet Indicated As 1 1/2" Shall be Changed to 1 3/4".

DETAILS AT OKLA. MORTGAGE AND 111 KERR BUILDINGS
Scale: 1 1/2" = 1'-0"


REVISION	DESCRIPTION	DATE
△1	Added Addenda Items	1 Mar. 74
△2	As Built Conditions	1 Mar. 74
3		
4		
5		
6		


KERR-McGEE CENTER
OKLAHOMA CITY OKLAHOMA


WALL SECTIONS


COMM. NO. 8266.74
DATE 29 Sept. 1969
SHEET NO. A-34

FSEM
FRANKFURT · SHORT · EMERY · McKINLEY ARCHITECTS · ENGINEERS
MEMBER AMERICAN INSTITUTE OF ARCHITECTS
MEMBER AMERICAN SOCIETY OF HEATING, REFRIGERATING AND AIR CONDITIONING ENGINEERS

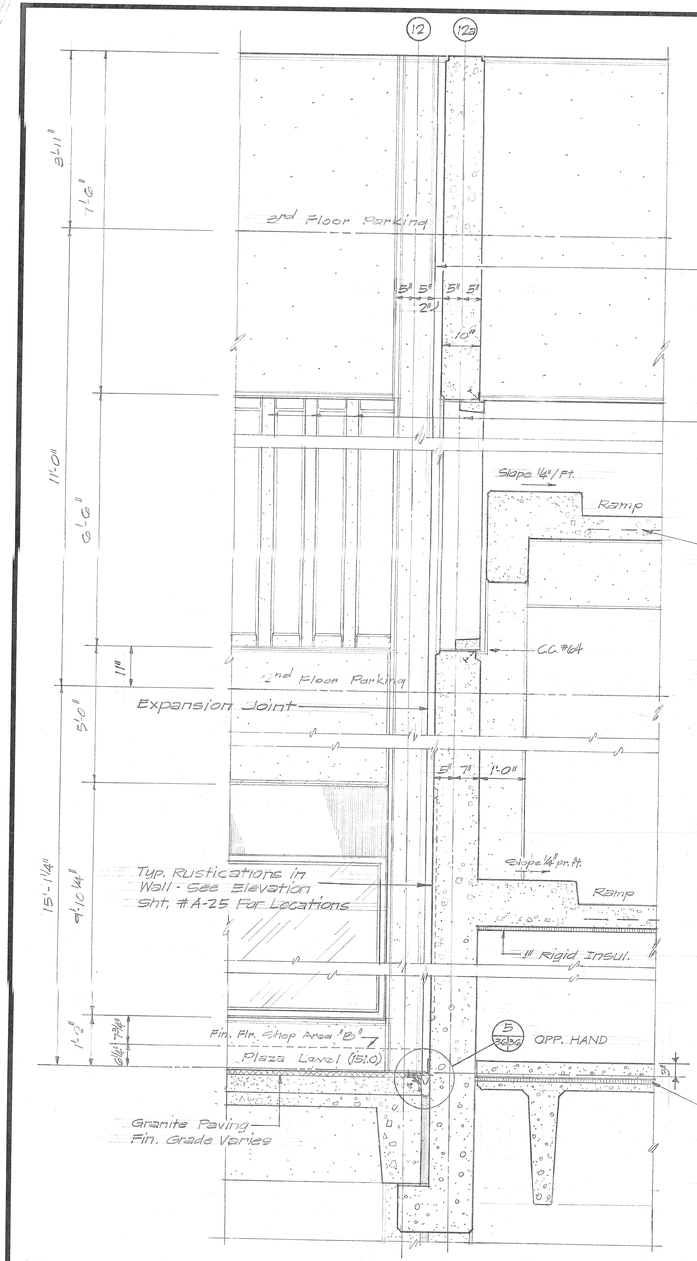

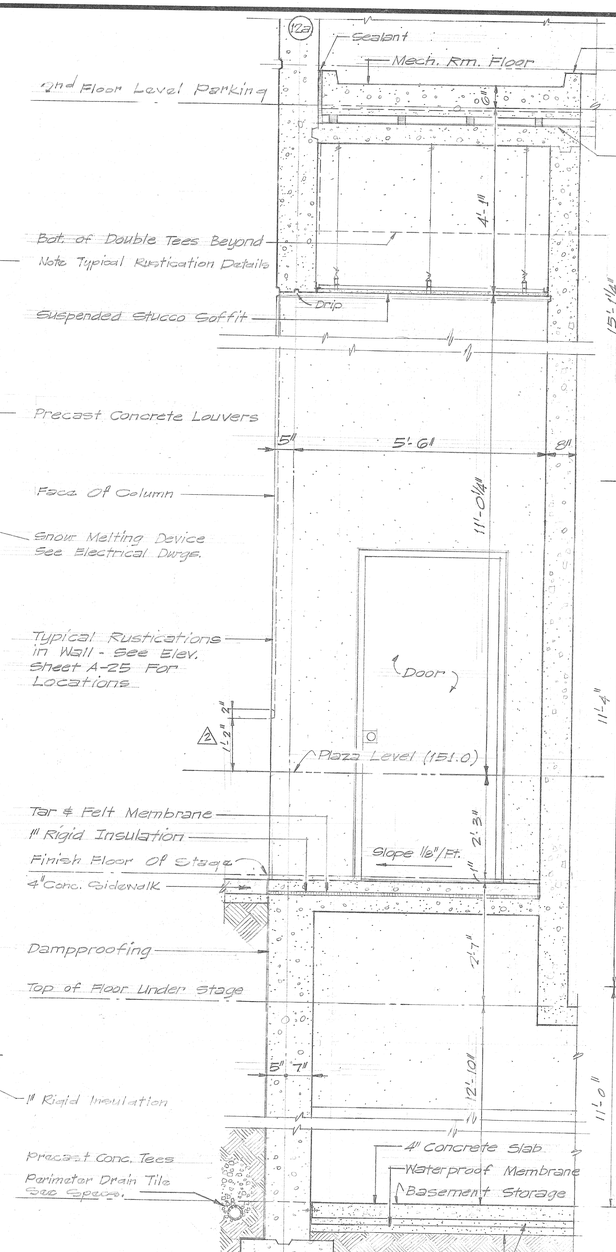

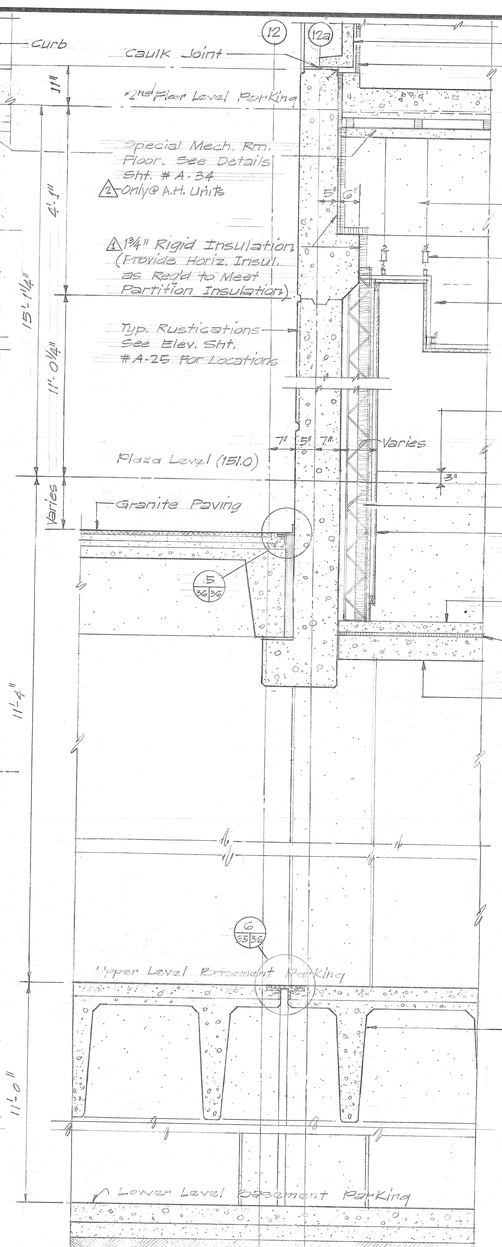

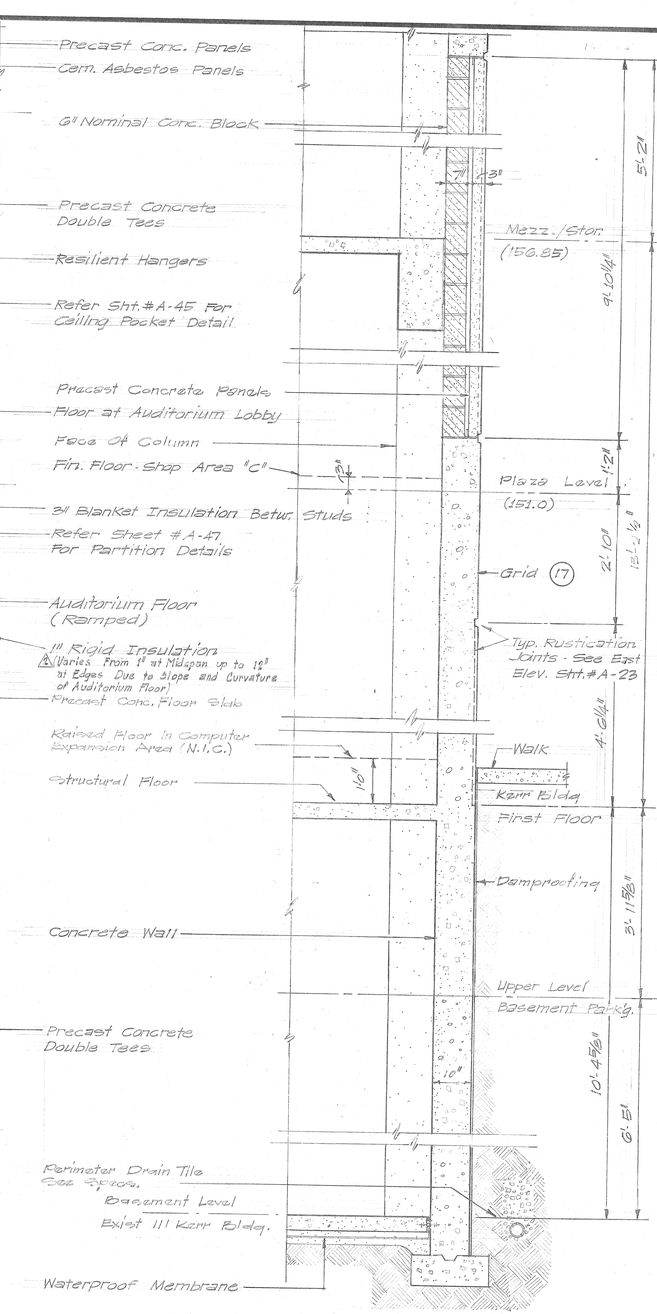

(1) 8/35 WALL SECTION @ EAST RAMPS
Scale 3/4"=1'-0"

(2) 9/35 WALL SECTION @ AUDITORIUM
Scale 3/4"=1'-0" W. WALL AT STAGE DOOR

(3) 9/35 Add'd # Pg 6 WALL SECTION @ AUDITORIUM
Scale 3/4"=1'-0" WEST WALL

(4) 9/35 WALL SECTION @ EXTERIOR WALL
Scale 3/4"=1'-0" E. WALL AT STOR. RM. # P-37

A NOTE:
All Precast D.B.L. Tees Are 8'-0" O.C. W/ 32" Depth.

Note: All Rigid Insulation This Sheet Indicated As 1" Wall Shall Be Changed To 1 5/8".


FSEM
FRANKFURT · SHORT · EMERY · McKINLEY ARCHITECTS · ENGINEERS
MEMBER AMERICAN INSTITUTE OF ARCHITECTS
MEMBER AMERICAN SOCIETY OF HEATING, REFRIGERATING AND AIR CONDITIONING ENGINEERS


REVISION	DESCRIPTION	DATE
A	Added Addenda Items	1 Mar. 74
2	As Built Conditions	1 Mar. 74
3		
4		
5		
6		

KERR-McGEE CENTER
OKLAHOMA CITY OKLAHOMA

WALL SECTIONS


COMM. NO. 56624
DATE 29 Sept. 1969
SHEET NO. A-35

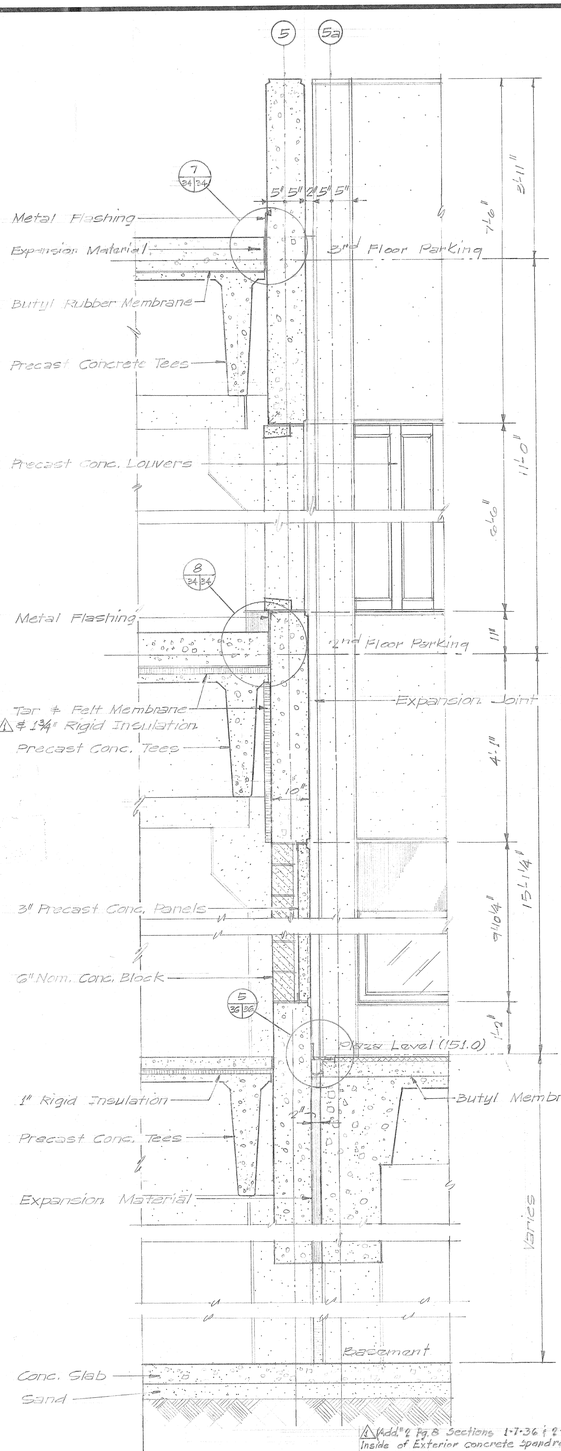

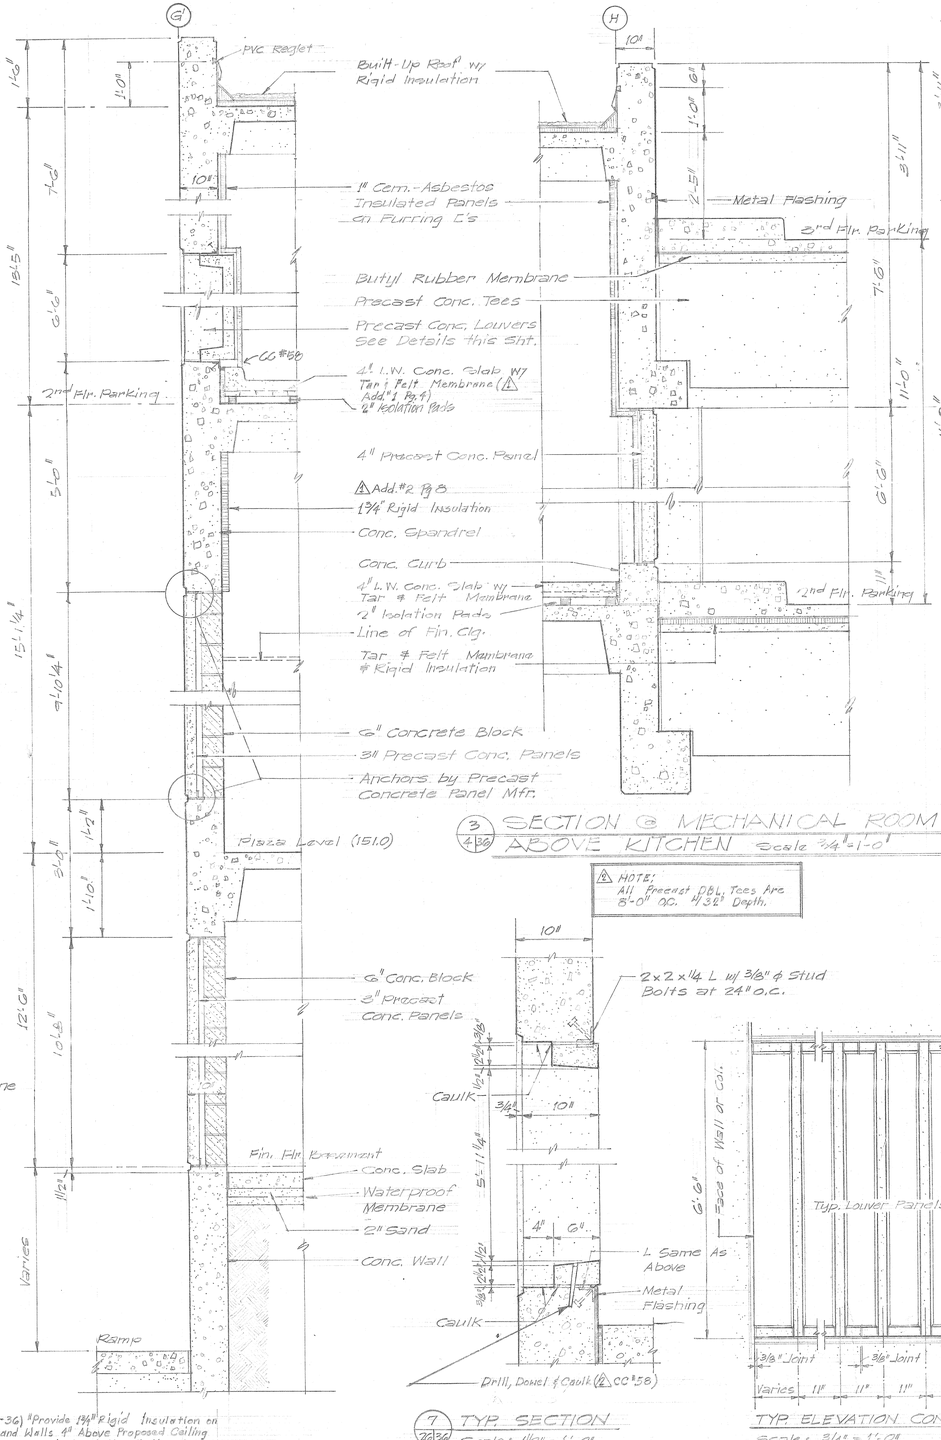

3 4/36 SECTION @ MECHANICAL ROOM ABOVE KITCHEN Scale ¾"=1'-0"


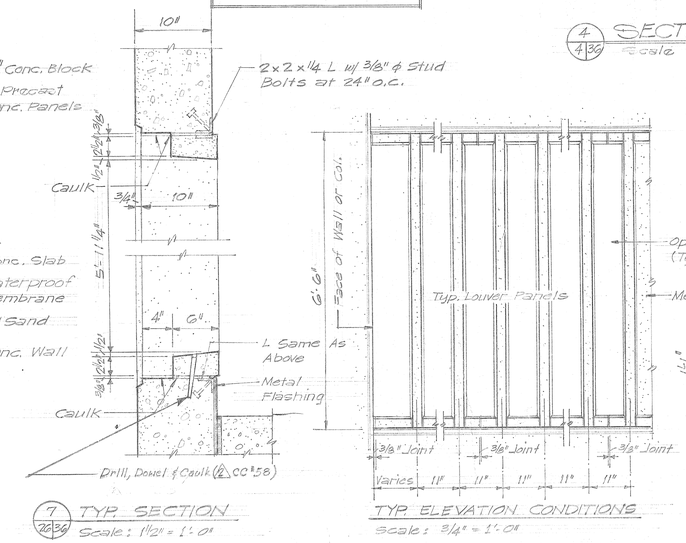


7 7/36 TYP. SECTION Scale: 1½"=1'-0"


TYP. ELEVATION CONDITIONS Scale: ¾"=1'-0"

CONCRETE LOUVER DETAILS


2ND FLR. PARKING GARAGE

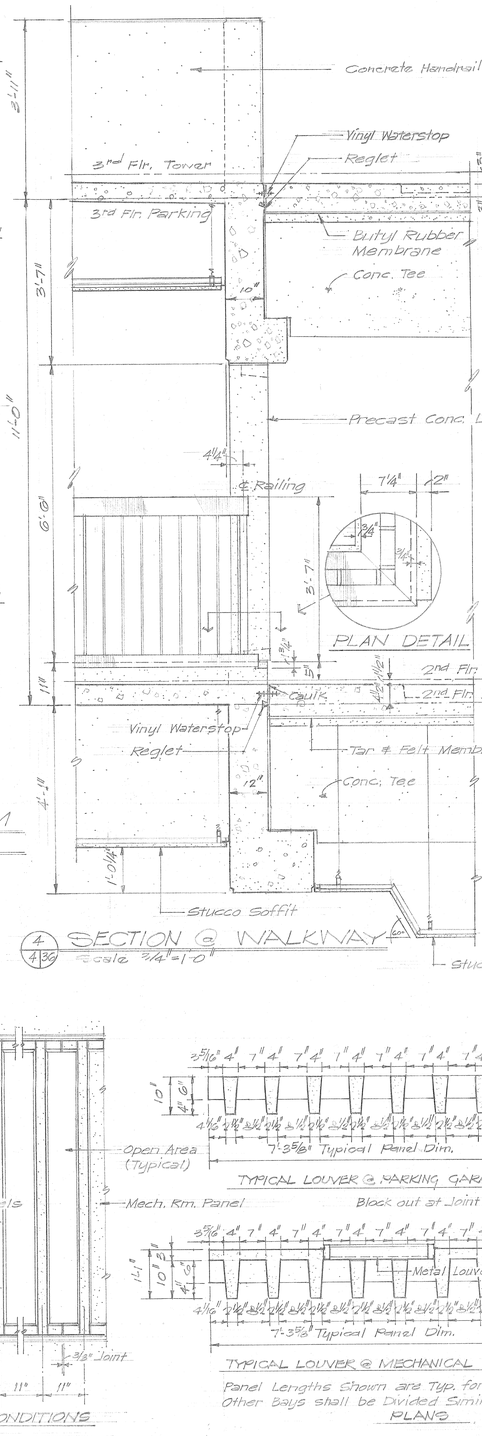


4 4/36 SECTION @ WALKWAY Scale ¾"=1'-0"

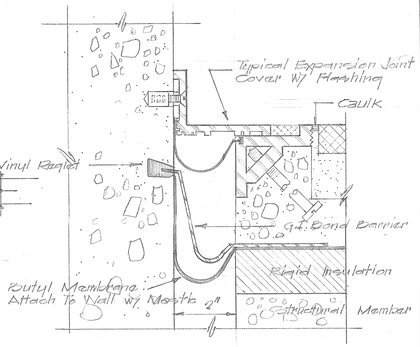


5 3/36 EXPANSION JOINT DETAIL Scale 1½" F.S.

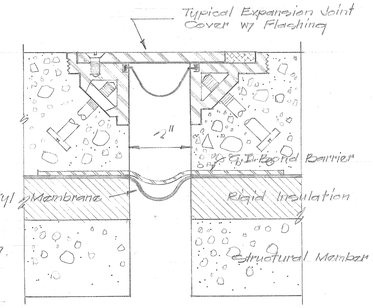

6 3/36 EXPANSION JOINT DETAIL Scale 1½" F.S.

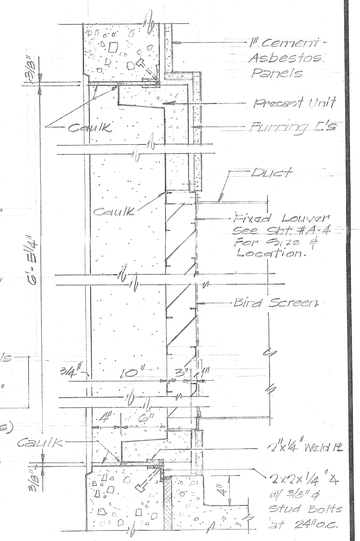

8 4/36 TYPICAL SECTION @ 2ND FLOOR MECHANICAL ROOM EXTERIOR Scale 1½"=1'-0"

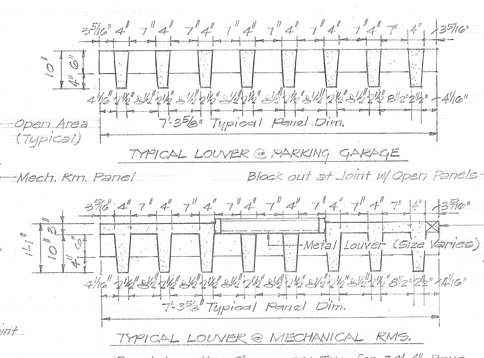

⚠ Add. #2 Pg. 8 Sections 1-7-36 & 2-7-36) "Provide 1¾" Rigid Insulation on Inside of Exterior concrete Spandrel and Walls 4" Above Proposed Ceiling Lines to the Bottom Side of the Second Floor Parking Level For all Shop Areas and Restaurant Spaces."

1 7/36 WALL SECTION @ SHOP AREA "A" Scale ¾"=1'-0"

⚠ Add. #2 Pg. 6

2 7/36 SECTION @ KITCHEN Scale ¾"=1'-0"

FSEM

FRANKFURT · SHORT · EMERY · McKINLEY **ARCHITECTS · ENGINEERS**

MEMBER AMERICAN INSTITUTE OF ARCHITECTS

MEMBER AMERICAN SOCIETY OF HEATING, REFRIGERATING AND AIR CONDITIONING ENGINEERS

REVISION	DESCRIPTION	DATE
⚠1	Added Addenda Items	1 May 74
⚠2	As Built Conditions	1 May 74
3		
4		
5		
6		


KERR-McGEE CENTER
OKLAHOMA CITY OKLAHOMA

WALL SECTIONS


COMM. NO. 2566.24
DATE 29 Sept. 1971
SHEET NO. A-310

TOWER WINDOW SCHEDULE


TYPE	FLOORS	SIZE R.O.
"A"	4 Thru 10	3'-5" x 6'-5"
"B"	11 Thru 19	8'-1" x 6'-5"
"C"	20 Thru 29	12'-9 x 6'-5"

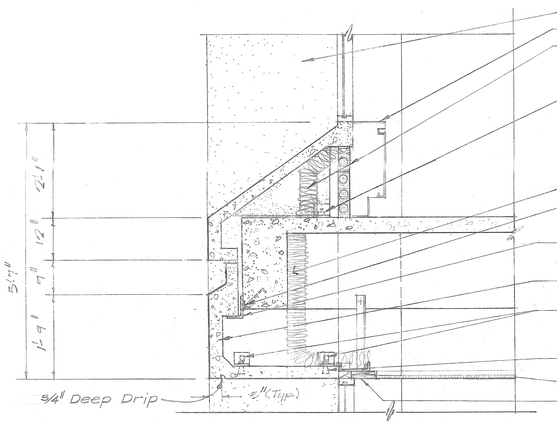


1/30|37 TYPICAL SPANDREL
Scale: 3/4" = 1'-0"

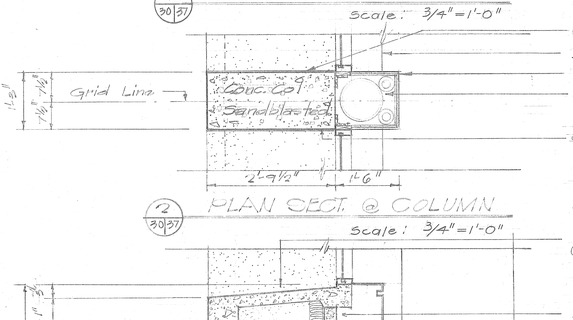


2/30|37 PLAN SECT. @ COLUMN
Scale: 3/4" = 1'-0"

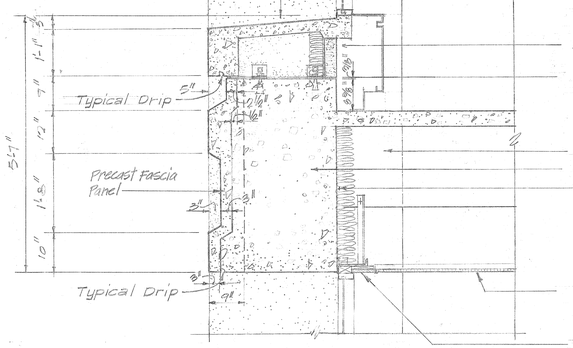


2/30|37 SPANDREL @ 11th & 20th FLOORS
Scale: 3/4" = 1'-0"

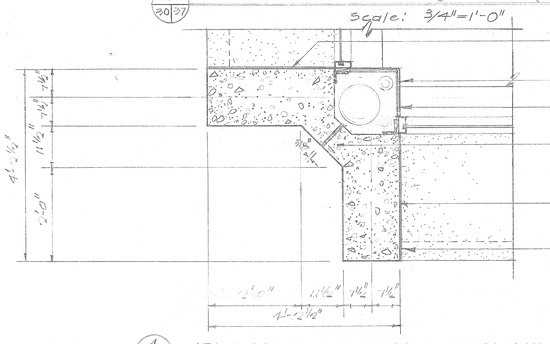


4/30|37 PLAN SECTION @ CORNER
Scale: 3/4" = 1'-0"

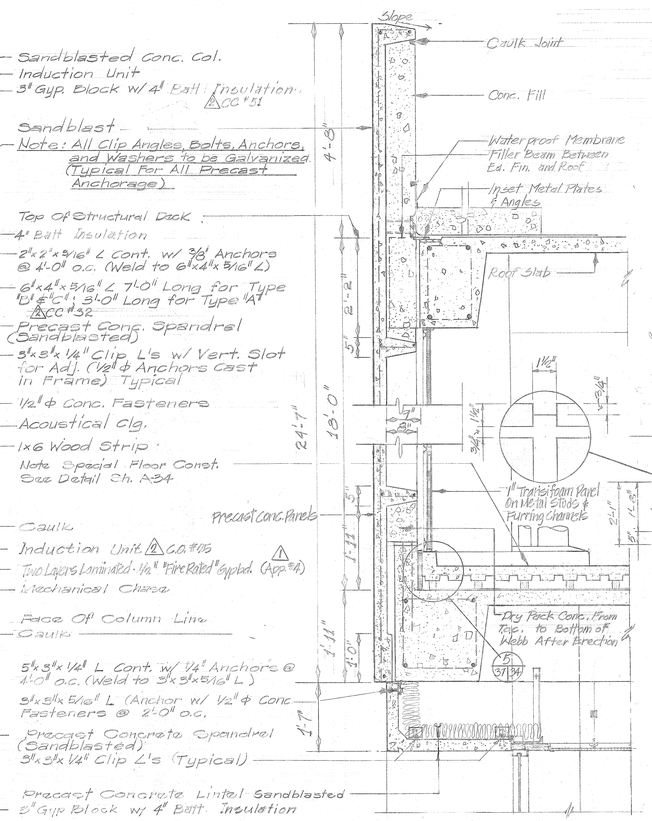


⚠CO #77 (Precast)
3/30|37 UPPER SPANDREL
Scale: 3/4" = 1'-0"

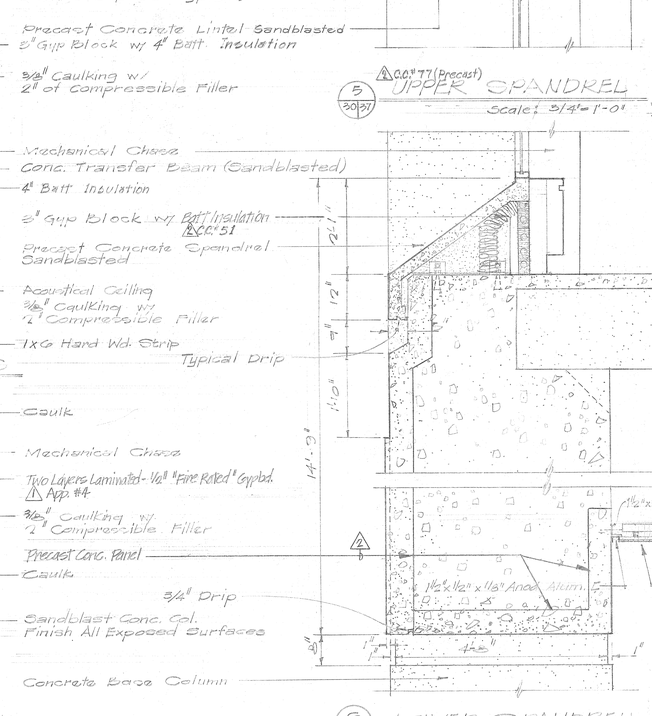


6/30|37 LOWER SPANDREL
Scale: 3/4" = 1'-0"

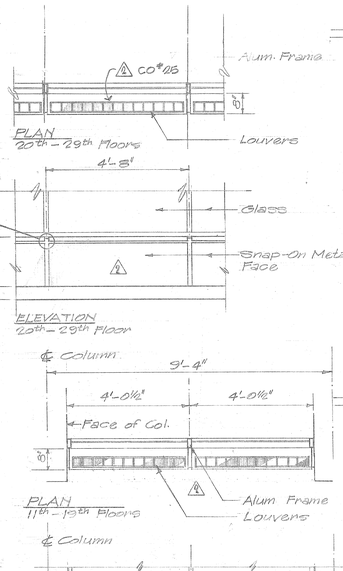

⚠CO #25
DET'LS INDUCTION UNIT — TOWER
Scale: 1 1/2" = 1'-0"

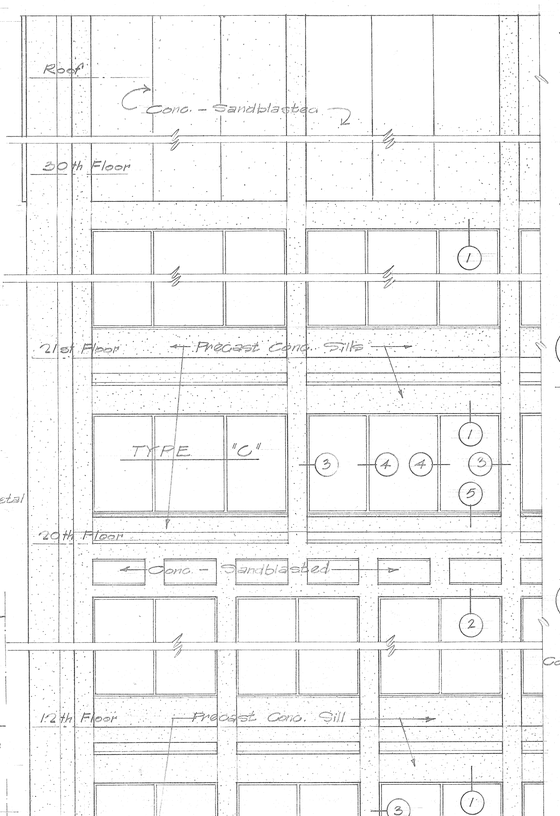

PARTIAL ELEVATION of TOWER
Scale: 1/4" = 1'-0"

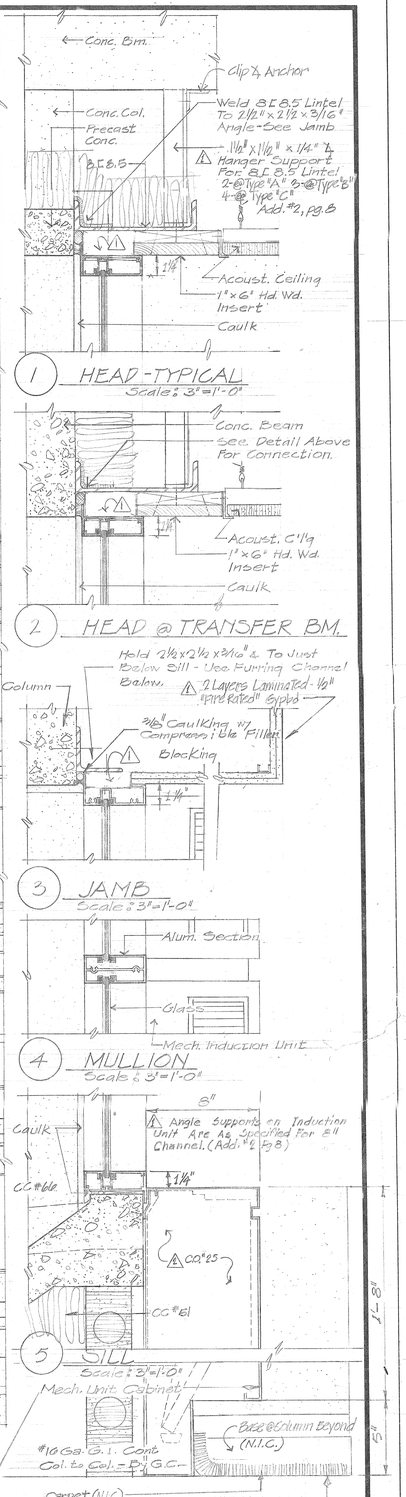

FSEM

FRANKFURT · SHORT · EMERY · McKINLEY **ARCHITECTS · ENGINEERS**

MEMBER AMERICAN INSTITUTE OF ARCHITECTS


MEMBER AMERICAN SOCIETY OF HEATING, REFRIGERATING AND AIR CONDITIONING ENGINEERS

REVISION	DESCRIPTION	DATE
1	Added Appendix & Addenda Items	1 Mar. 74
2	As Built Conditions	1 Mar. 74
3		
4		
5		
6		


KERR-McGEE CENTER
OKLAHOMA CITY OKLAHOMA

TOWER SPANDRELS


COMM. NO. 2666.24
DATE 19 Sept 1969
SHEET NO. A-37

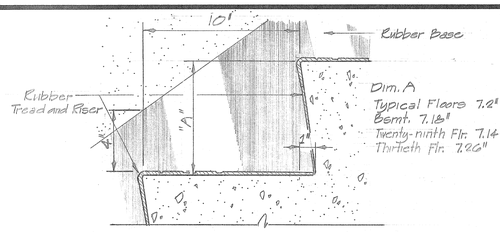


TYPICAL TREAD DETAIL
Scale: 6" = 1'-0"

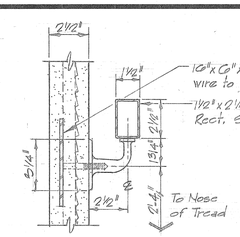


HANDRAIL DETAIL
Scale: 3/8" = 1'-0"

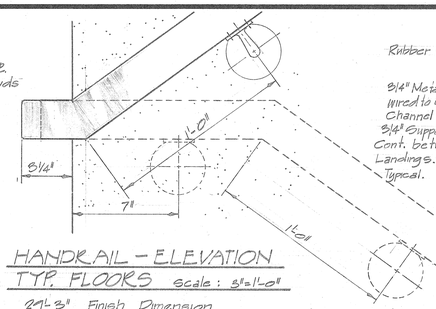


HANDRAIL - ELEVATION
TYP. FLOORS Scale: 3/8"=1'-0"

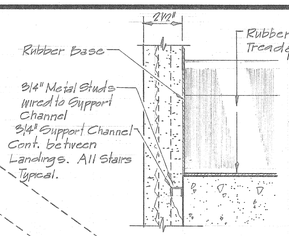


2 3/8"=1'-0" TYPICAL SECTION
Scale: 3" = 1'-0"

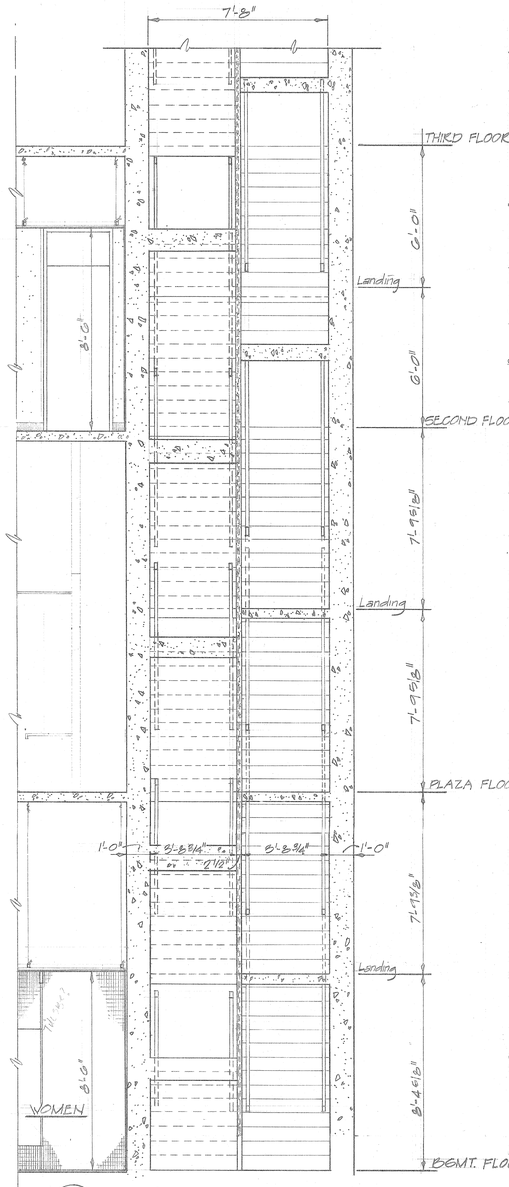

1 3/8"=1'-0" SECTION THRU STAIRS A and B
Scale: 3/8" = 1'-0"

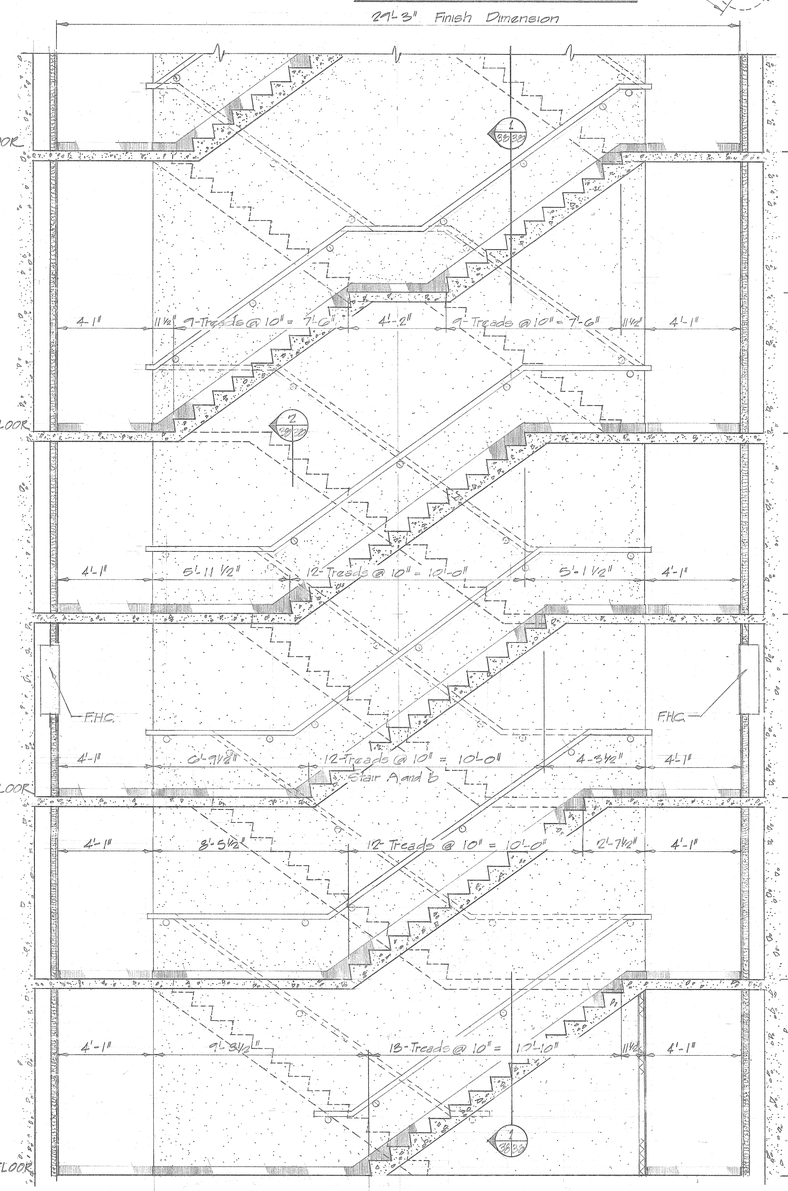

SECTION THRU STAIRS A and B
Scale: 3/8" = 1'-0"

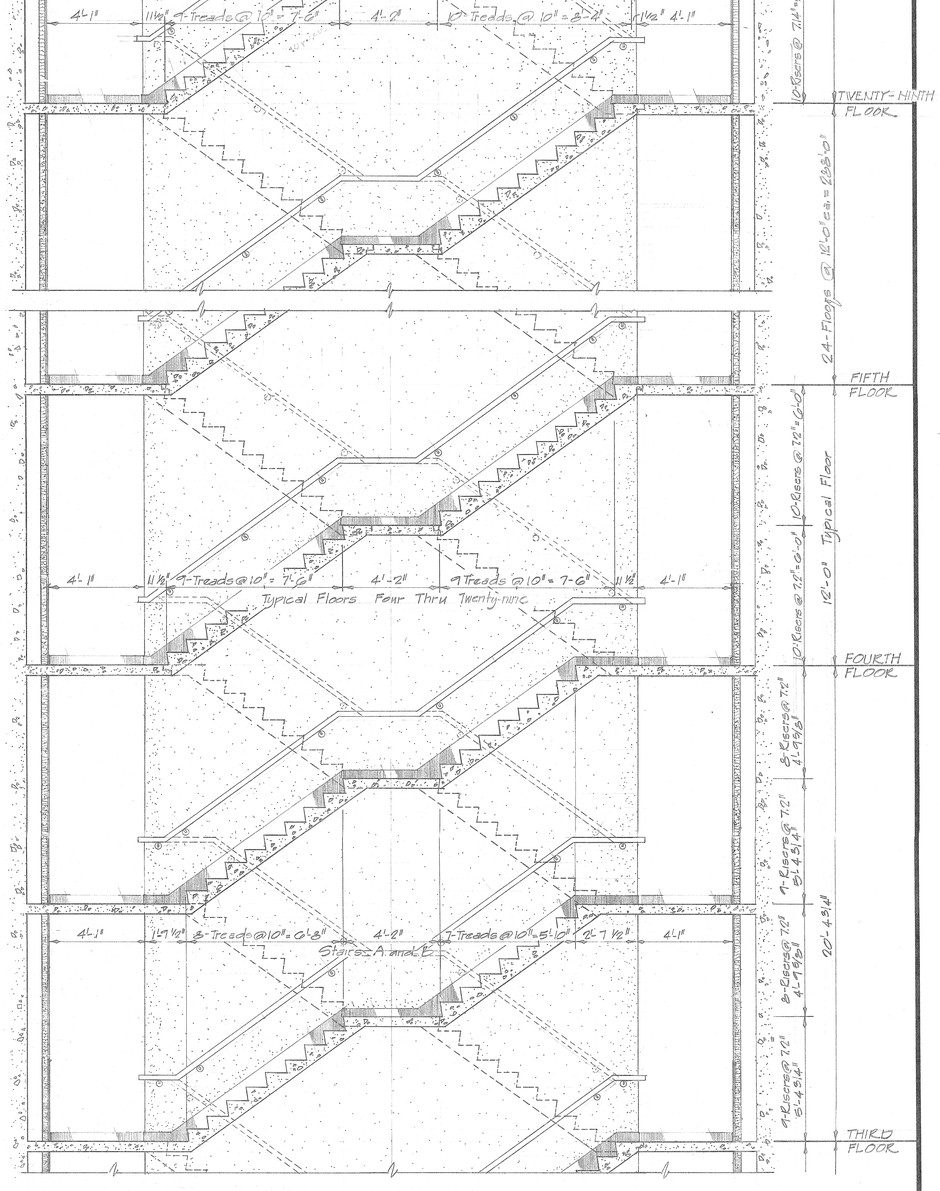

SECTION THRU STAIRS A and B
Scale: 3/8" = 1'-0"

⚠1 Note: Precast Stairs - second Floor to Third Floor & Fourth Floor to Twenty-Ninth. All others @ Stair "A" & "B" Are Poured In Place Concrete.

FSEM

FRANKFURT · SHORT · EMERY · McKINLEY **ARCHITECTS · ENGINEERS**

MEMBER AMERICAN INSTITUTE OF ARCHITECTS


MEMBER AMERICAN SOCIETY OF HEATING, REFRIGERATING AND AIR CONDITIONING ENGINEERS

REVISION	DESCRIPTION	DATE
1	As Built Condition	1 Mar. 74
2		
3		
4		
5		
6		

KERR - McGEE CENTER
OKLAHOMA CITY OKLAHOMA


STAIRS "A" AND "B"

COMM. NO. 366-24
DATE 29 Sept. 1969
SHEET NO. A-38

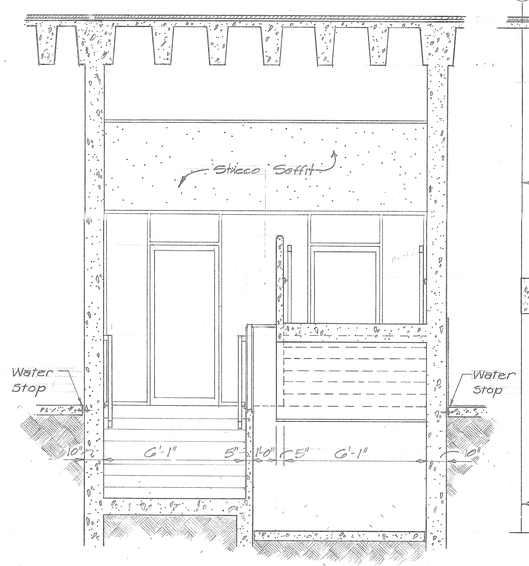


3/39 SECTION THRU STAIR-F

Scale: 3/8" = 1'-0"

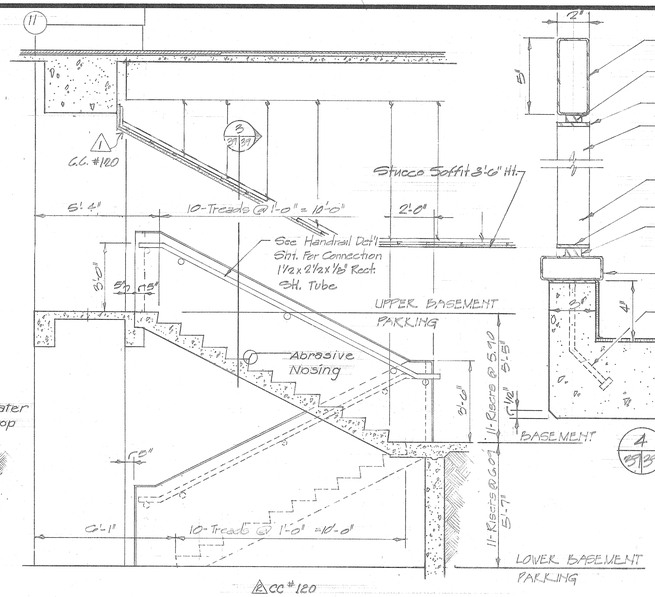


SECTION THRU STAIR-"F"

Scale: 3/8" = 1'-0"

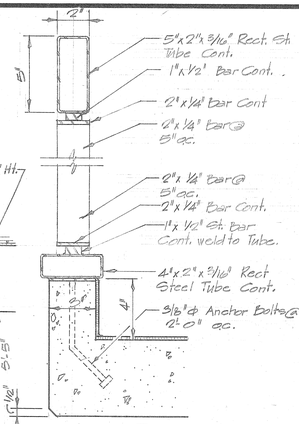


4/39 HANDRAIL DETAILS

Scale: 3" = 1'-0"

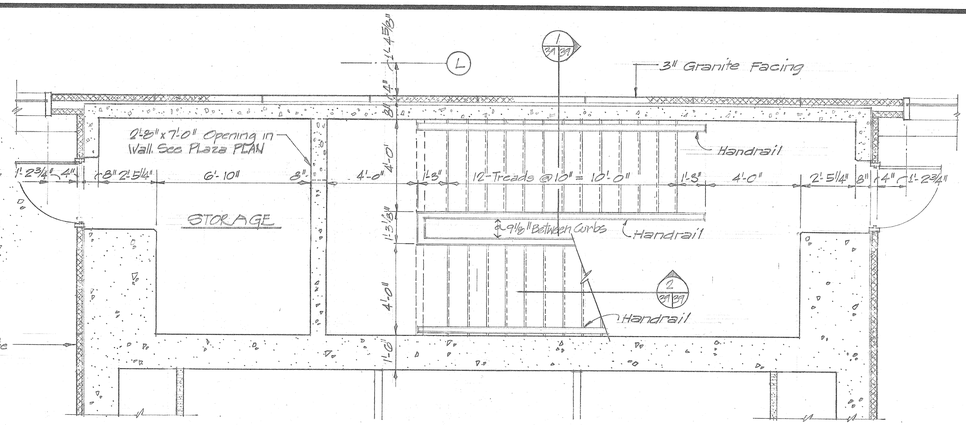


PLAN - PLAZA FLOOR STAIR-C

Scale: 3/8" = 1'-0"

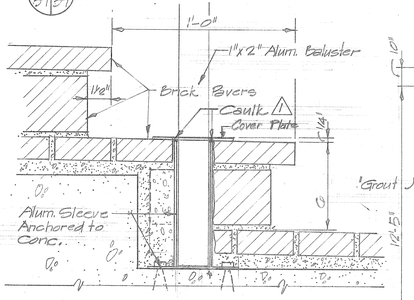


TREAD and RISER DETAIL

Scale: 3" = 1'-0"

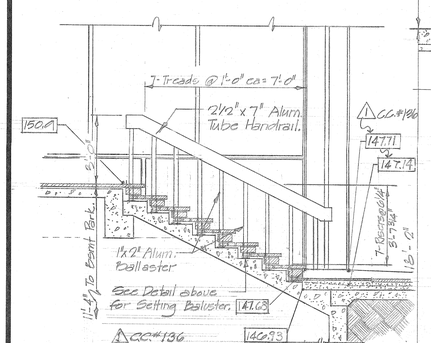


SECTION THRU STAIR at EAST CONCOURSE

Scale: 3/8" = 1'-0"

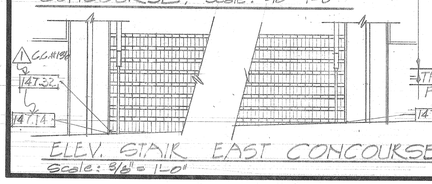


ELEV. STAIR EAST CONCOURSE

Scale: 3/8" = 1'-0"

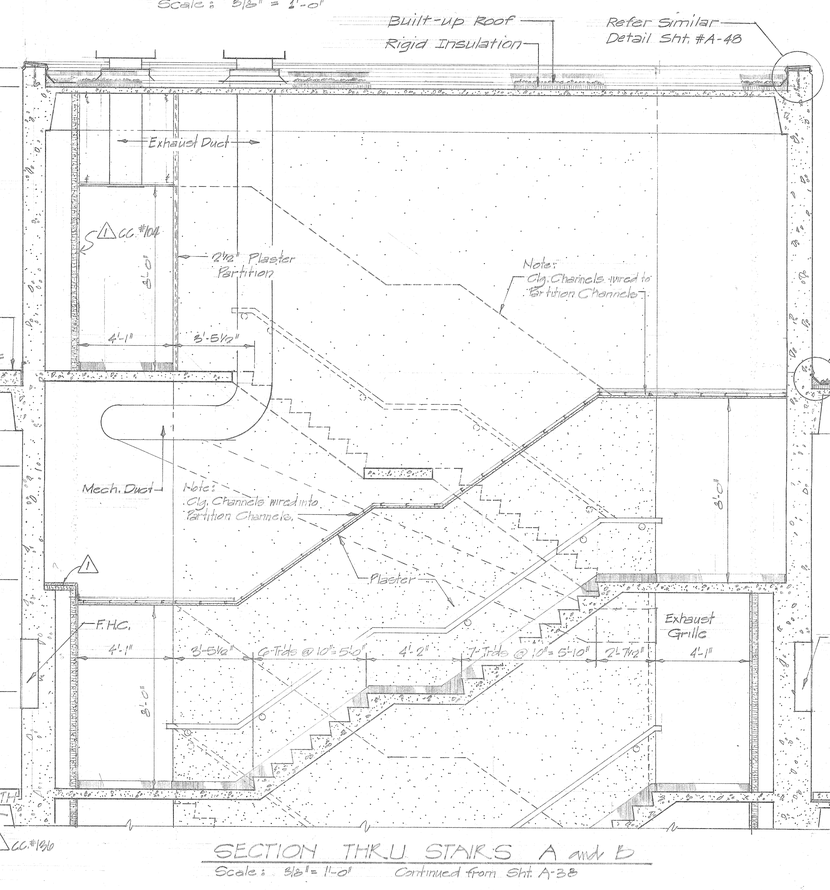


SECTION THRU STAIRS A and B


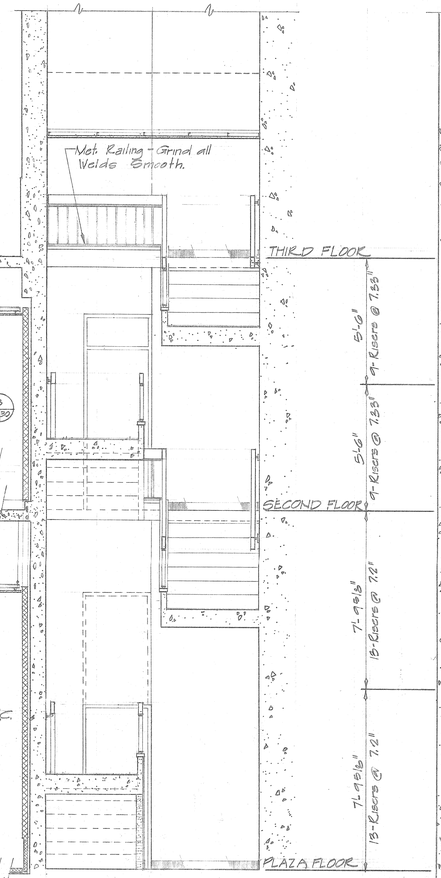

1/39 SECTION THRU STAIR-C

Scale: 3/32" = 1'-0"

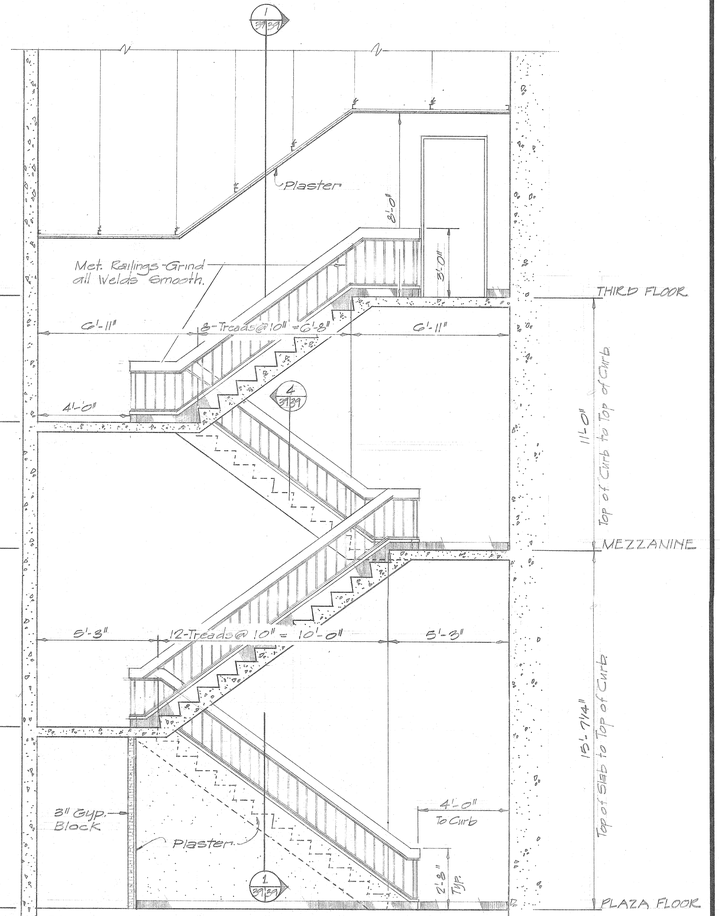

2/39 SECTION THRU STAIR-C

Scale: 3/32" = 1'-0"

FRANKFURT · SHORT · EMERY · McKINLEY ARCHITECTS · ENGINEERS

FSEM

MEMBER AMERICAN INSTITUTE OF ARCHITECTS

MEMBER AMERICAN SOCIETY OF HEATING, REFRIGERATING AND AIR CONDITIONING ENGINEERS

REVISION	DESCRIPTION	DATE
1	As Built Conditions	1 Mar. 74
2		
3		
4		
5		
6		


KERR-McGEE CENTER
OKLAHOMA CITY OKLAHOMA

STAIRS "A"-"B"-"C"-"F"


COMM. NO. 3666.24

DATE 29 Sept. 1969


SHEET NO. A-39

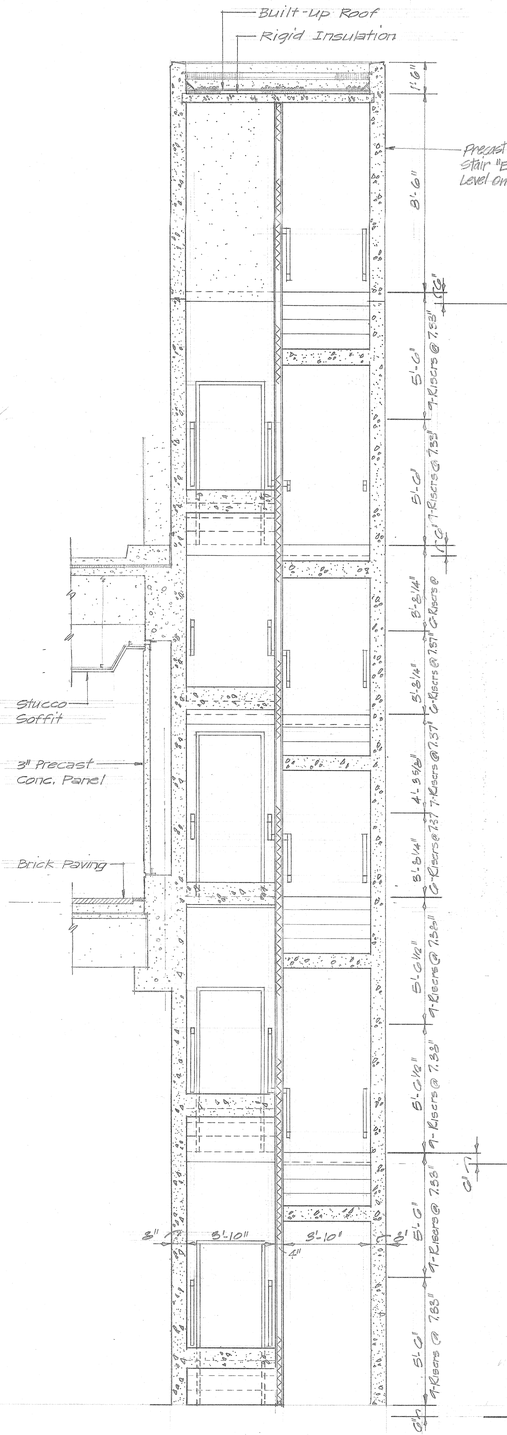


1 SECTION THRU STAIR - E
4040 Scale: 3/8" = 1'-0"

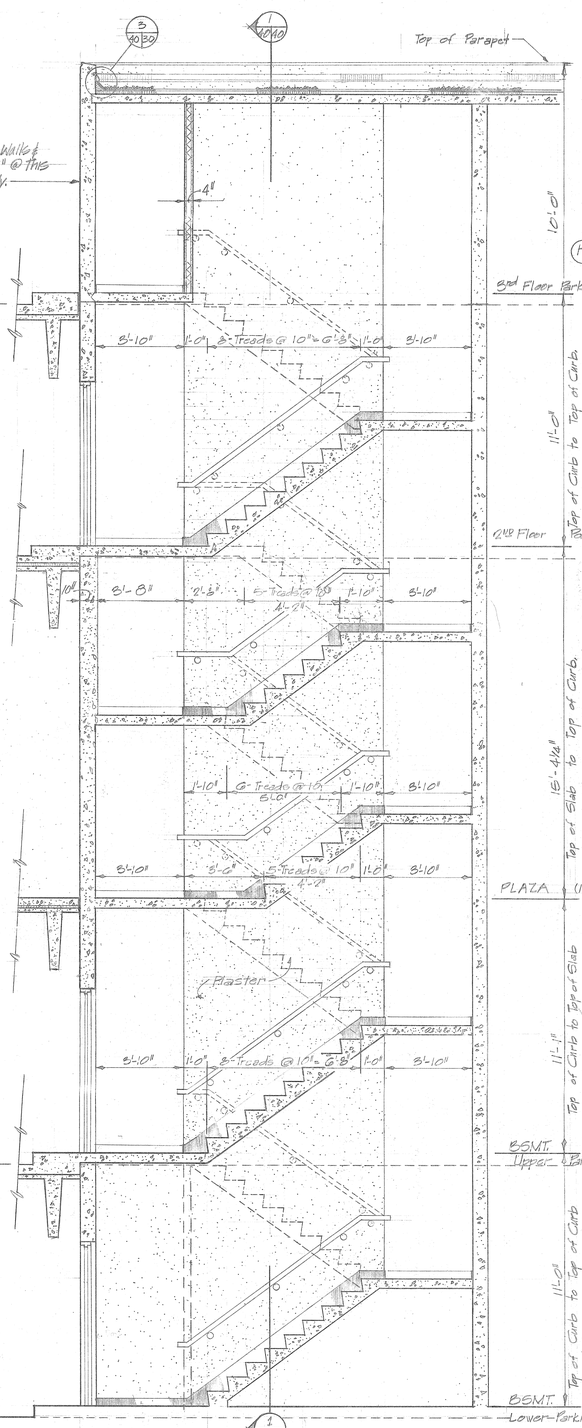

2 SECTION THRU STAIR - E
4040 Scale: 3/8" = 1'-0"

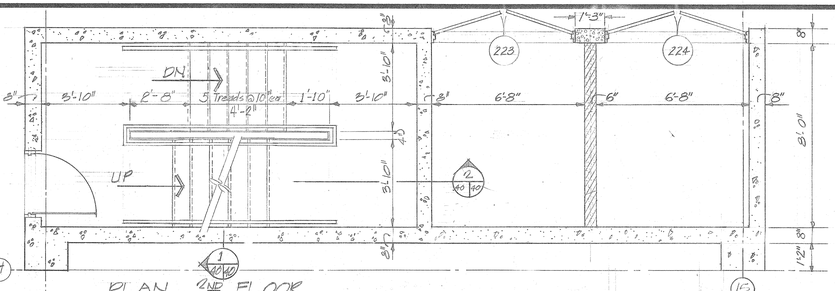


PLAN 2ND FLOOR STAIR - E
Scale: 3/8" = 1'-0"

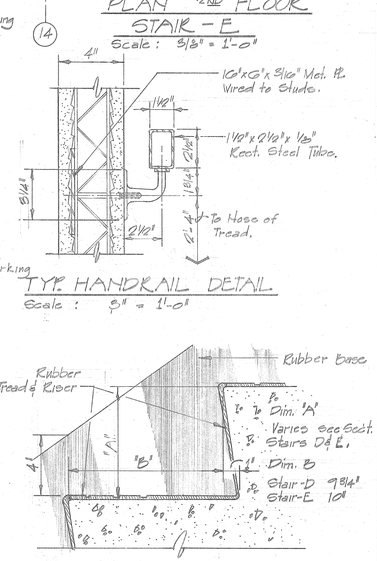


TYP. HANDRAIL DETAIL
Scale: 3" = 1'-0"


TYPICAL TREAD DETAIL
Scale: 3" = 1'-0"

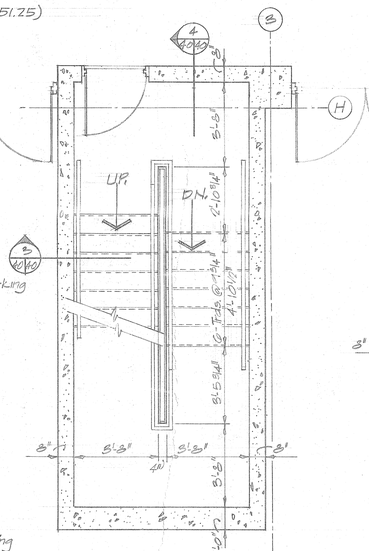

PLAN - 2ND FLOOR STAIR - D
Scale: 3/8" = 1'-0"

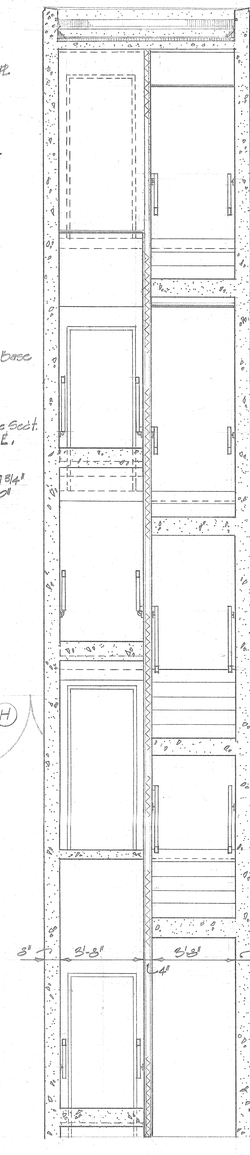

3 SECTION THRU STAIR - D
4040 Scale: 3/8" = 1'-0"

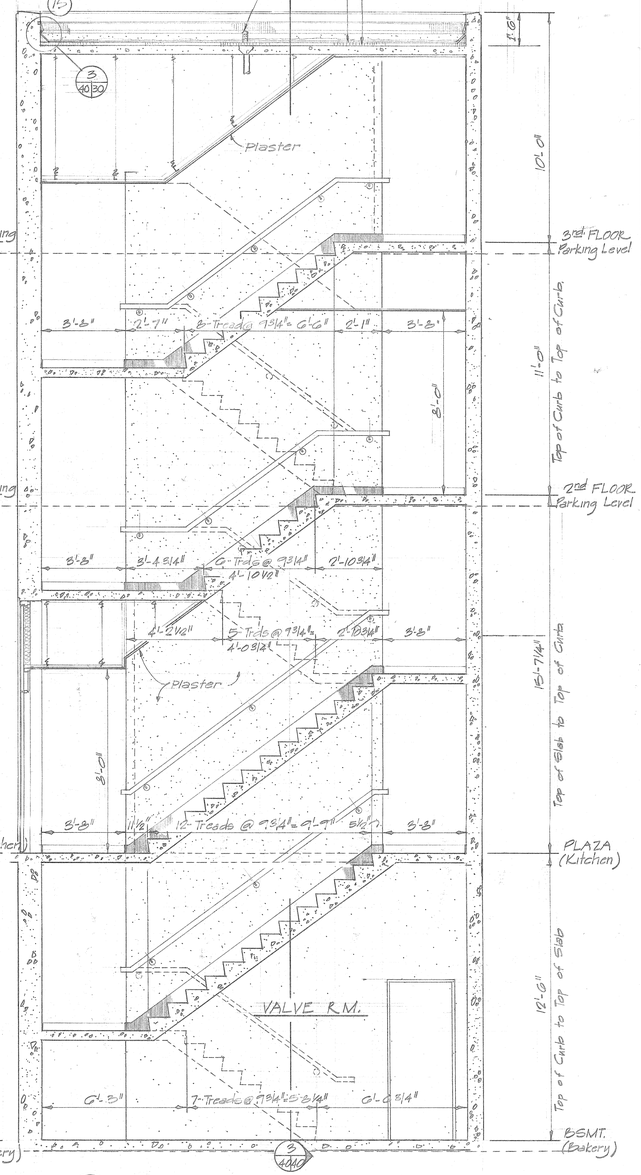

4 SECTION THRU STAIR - D
4040 Scale: 3/8" = 1'-0"

FRANKFURT · SHORT · EMERY · McKINLEY **ARCHITECTS · ENGINEERS**

MEMBER AMERICAN INSTITUTE OF ARCHITECTS

MEMBER AMERICAN SOCIETY OF HEATING, REFRIGERATING AND AIR CONDITIONING ENGINEERS


FSEM

REVISION	DESCRIPTION	DATE
1	As Built Conditions	1 May 74
2		
3		
4		
5		
6		

KERR-McGEE CENTER
OKLAHOMA CITY OKLAHOMA

STAIRS "D" AND "E"

COMM. NO. 3666.24
DATE 29 Sept 1969
SHEET NO. A-40

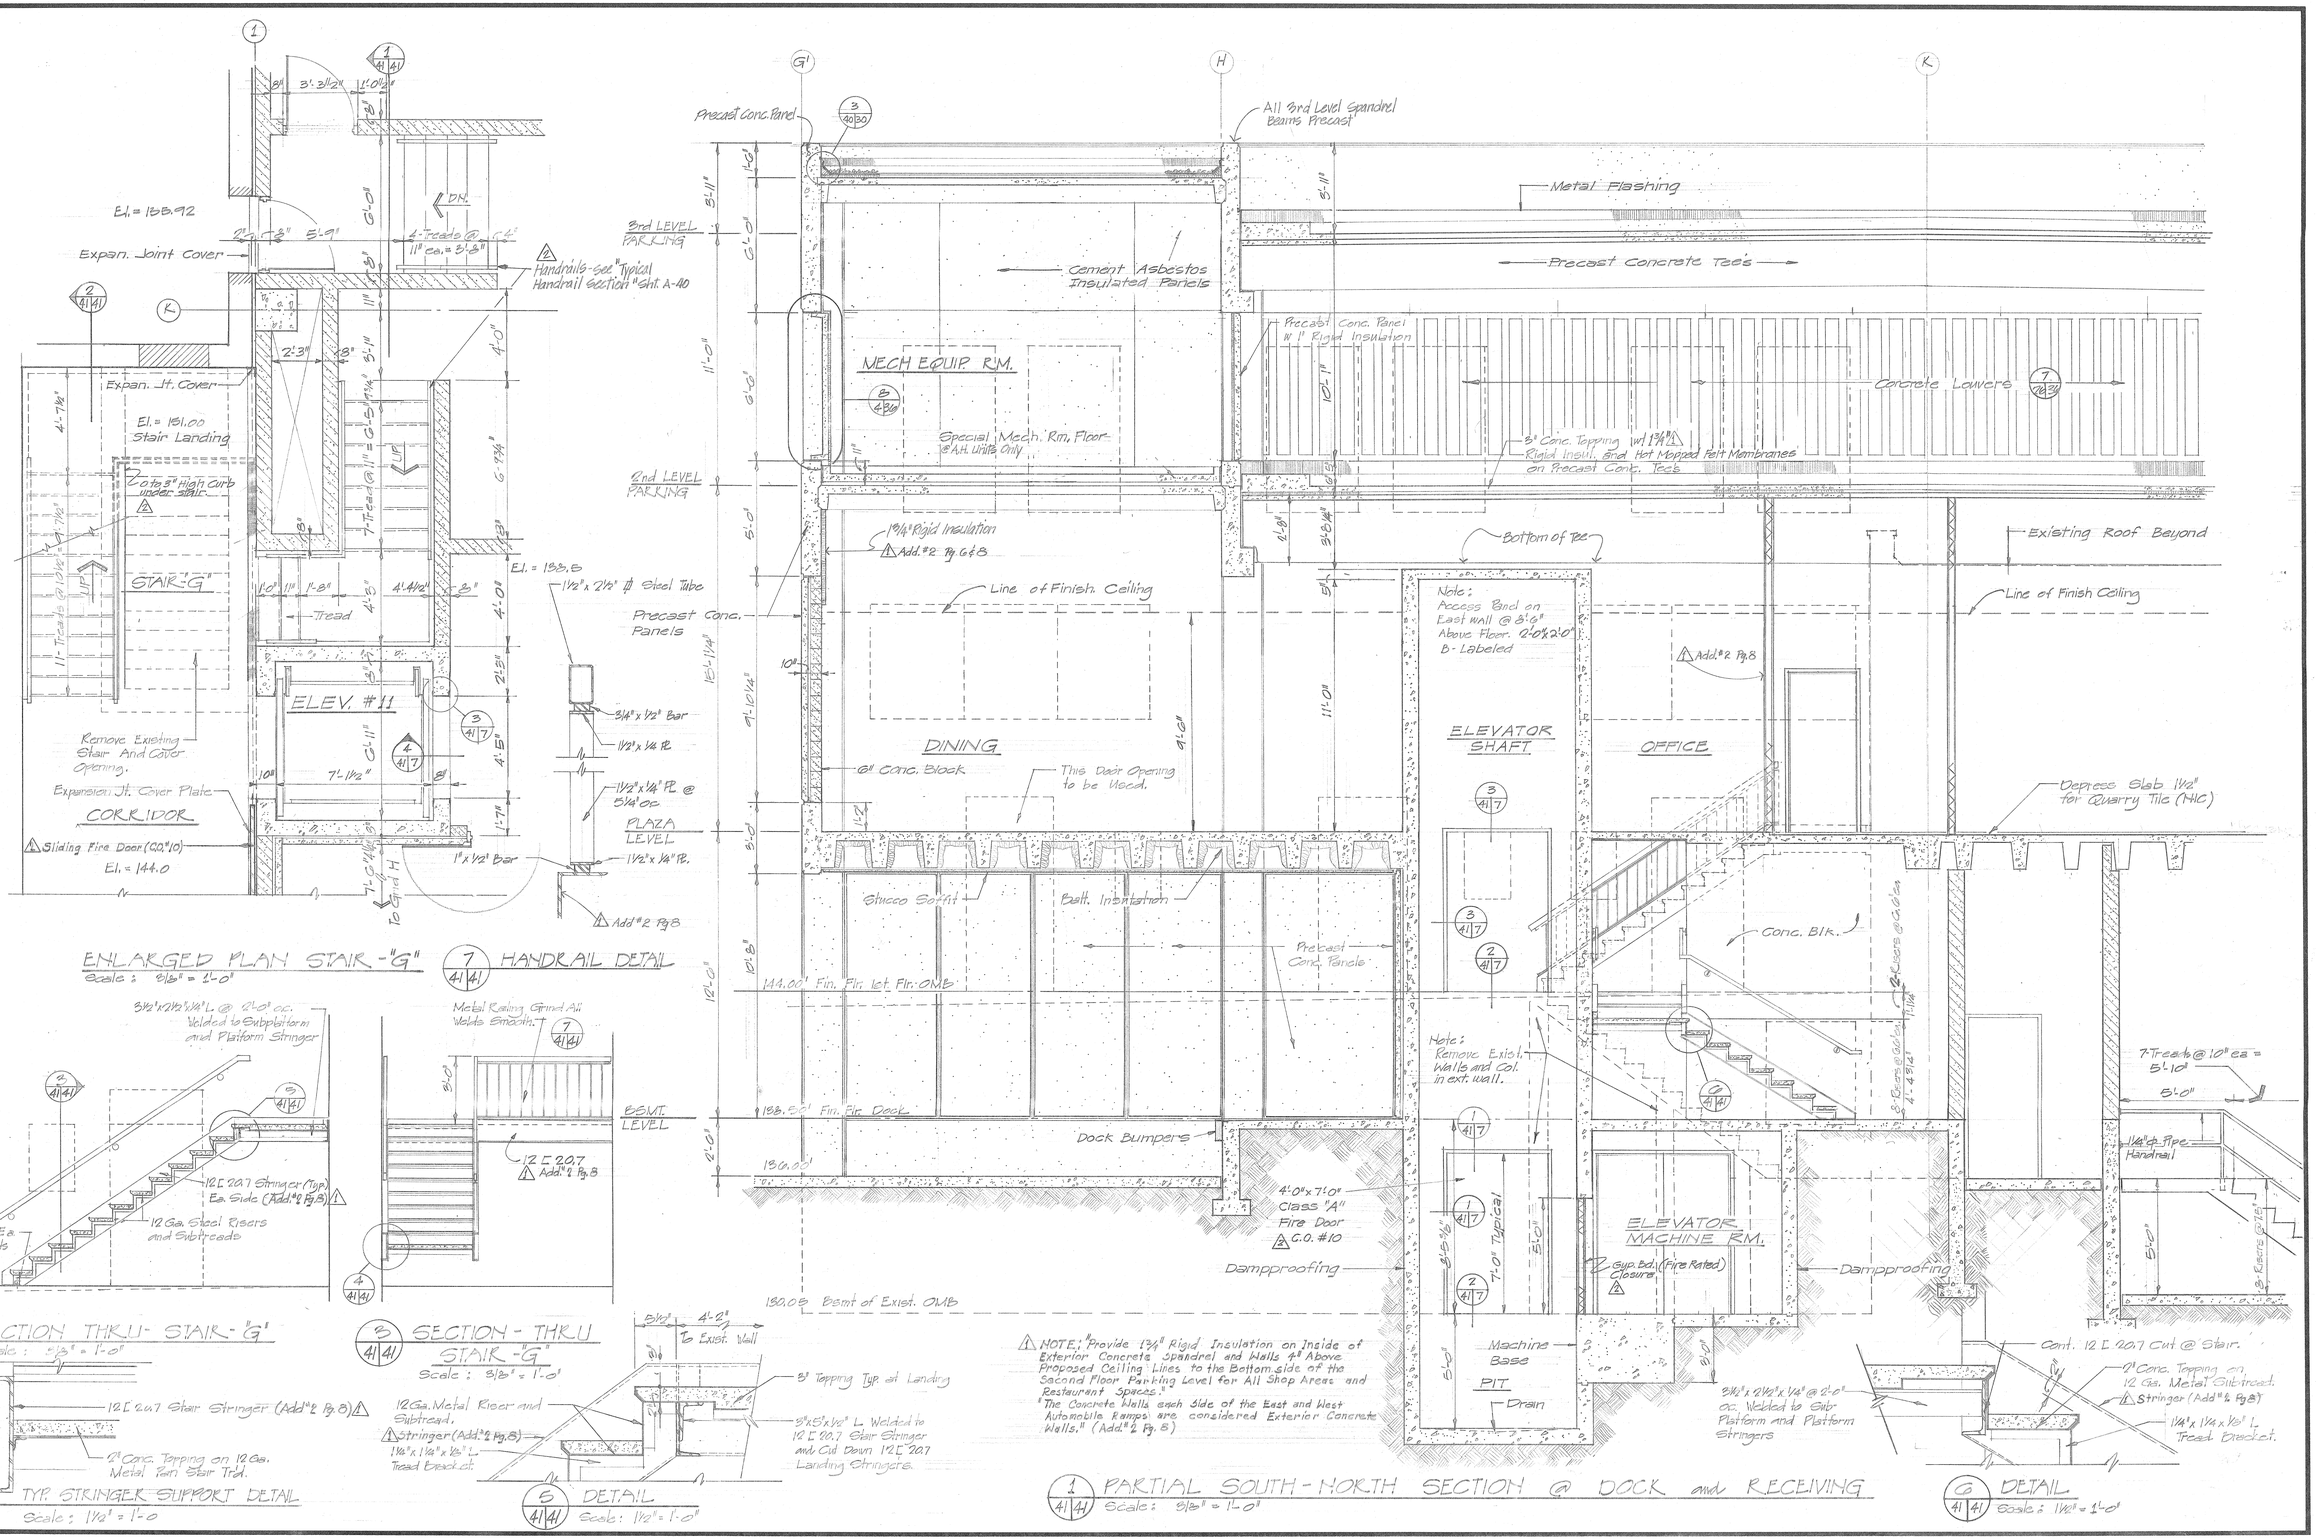

FRANKFURT · SHORT · EMERY · McKINLEY **ARCHITECTS · ENGINEERS**

MEMBER AMERICAN INSTITUTE OF ARCHITECTS

MEMBER AMERICAN SOCIETY OF HEATING, REFRIGERATING AND AIR CONDITIONING ENGINEERS

FSEM

REVISION	DESCRIPTION	DATE
1	Added Addenda Items	1 Mar. 74
2	As Built Conditions	1 Mar. 74
3		
4		
5		
6		


KERR-McGEE CENTER
OKLAHOMA CITY, OKLAHOMA

STAIR "G"

COMM. NO. 3666'24

DATE 27 Sept. 1973

SHEET NO. A-41

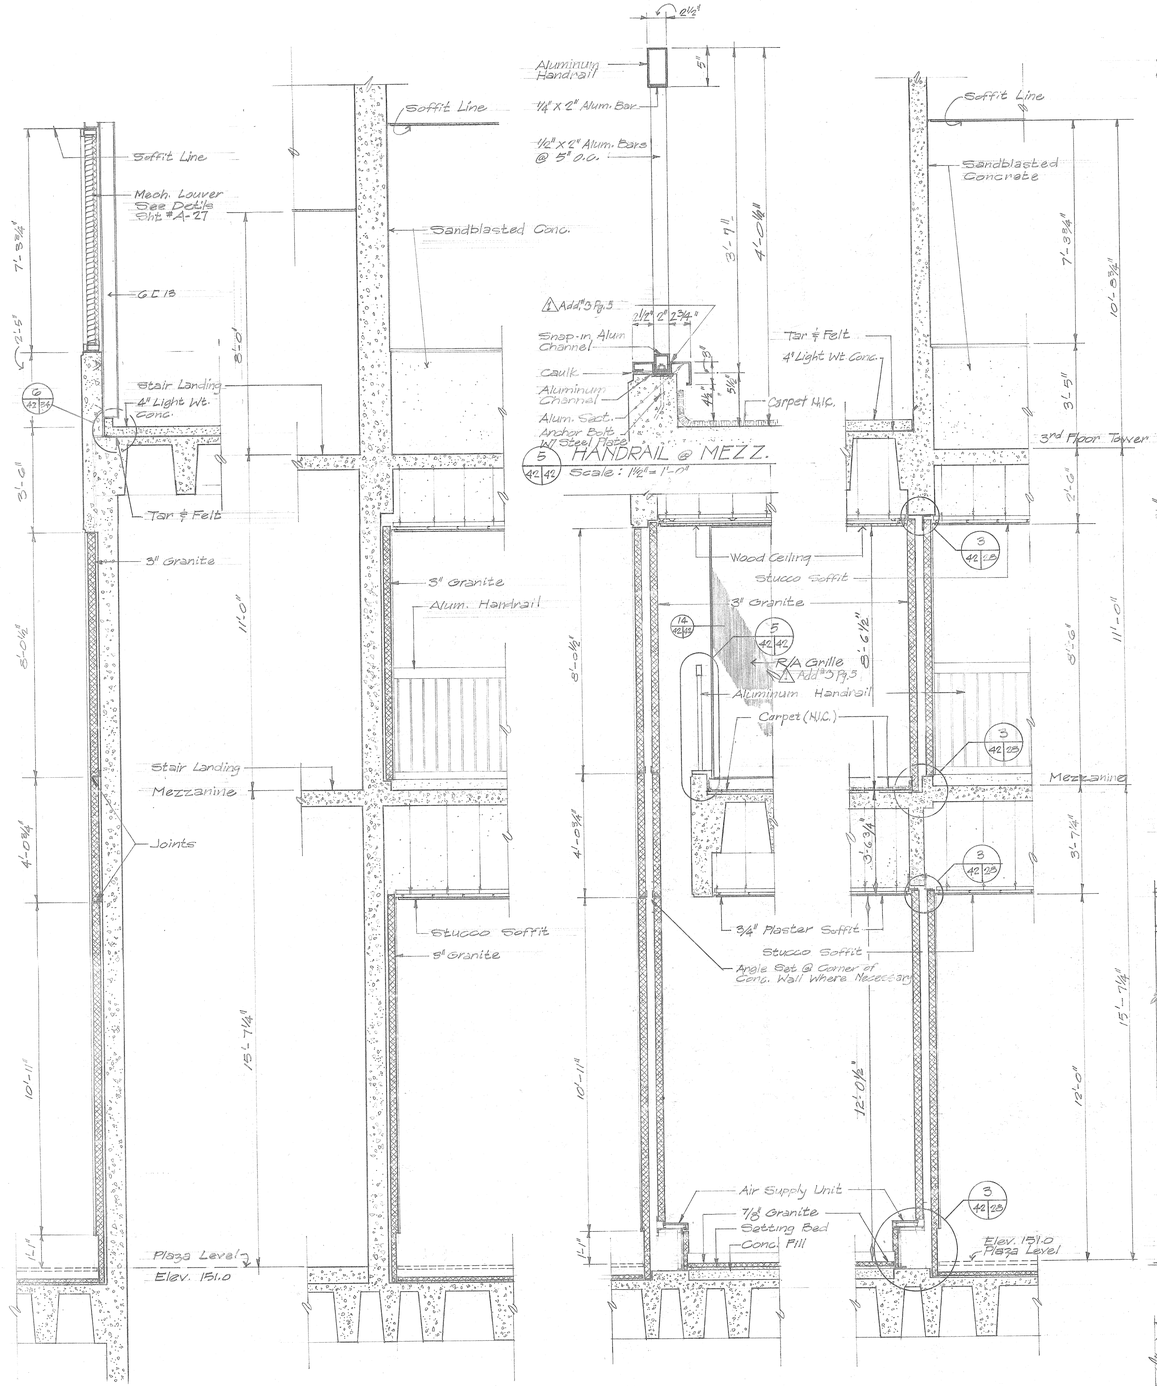


1 / 11/42 SECT.-SOUTH LOBBY WALL @ CHASE
Scale: 1/2" = 1'-0"

HANDRAIL @ MEZZ.
Scale: 1½" = 1'-0"

2 / 11/42 SECT.-NORTH LOBBY WALL @ STAIR LANDING
Scale: 1/2" = 1'-0"


3 / 11/42 ⚠ Omit Granite Floor @ Mezz. Level. (App. 9.7) SECT. @ SOUTH WING WALL-LOBBY.
Scale: 1/2" = 1'-0"

4 / 11/42 ⚠ Omit Granite Floor @ Mezz. Level (App. 9.7) SECT. @ NORTH WING WALL-LOBBY.
Scale: 1/2" = 1'-0"

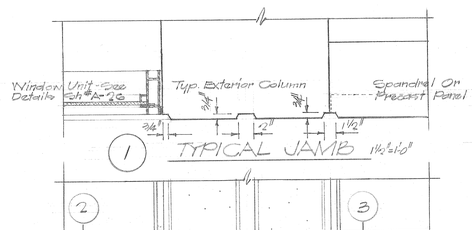


TYPICAL JAMB 1½"=1'-0"

TYPICAL HEAD & SILL 1½"=1'-0"

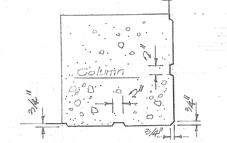

EXTERIOR CORNER

TYPICAL RUSTICATION DETAILS

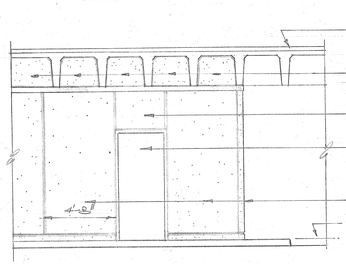


ELEVATION




TYPICAL JOINT TYPICAL CORNER 1½"=1'-0"


TYPICAL MECHANICAL RM. DETAILS

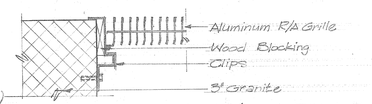

14 / 42/42 SECTION-R/A GRILLE
⚠ Add #3 Pg. 5 Inside of Connecting Ductwork Painted Flat Black.

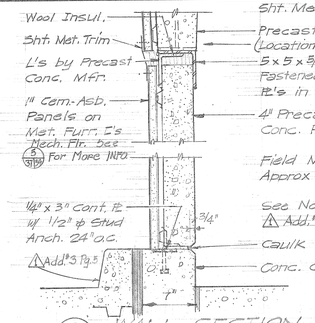


6 / A/42 WALL SECTION
2ND FLR. MECH. RMS.
Scale: 1½" = 1'-0"

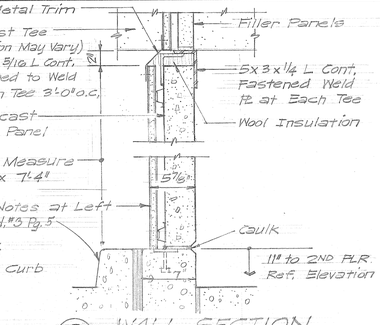


7 / 4/42 WALL SECTION
2ND FLR. MECH. RMS.
Scale: 1½" = 1'-0"

Note: See Details Above For Typical Connections to Double Tees Above Basement Equip. Rms.

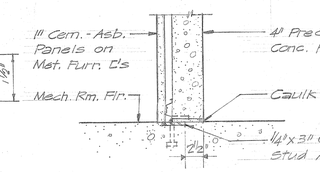


8 / 1/42 WALL SECTION
MECH RMS LB-5 & UB-1
Scale: 1½" = 1'-0"

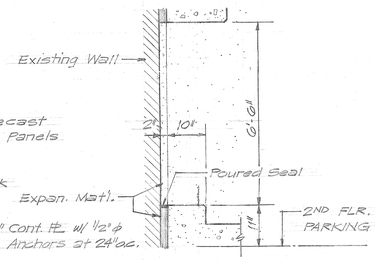


9 / 1/42 WALL SECTION
AT 111 KERR BLDG & O.M. BLDGS.
Scale: 3/4" = 1'-0"

10 / 8/42 WALL SECTION
N. CONCOURSE
Scale: 3/4" = 1'-0"

11 / 9/42 WALL SECTION
E. CONCOURSE
Scale: 3/4" = 1'-0"

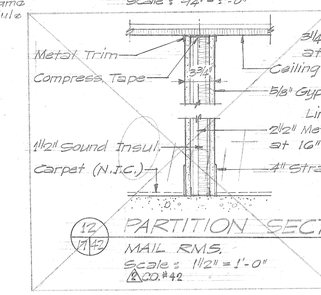

12 / 17/42 PARTITION SECT.
MAIL RMS.
Scale: 1½" = 1'-0"
⚠ 00. #42

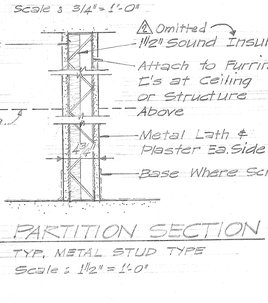

13 / -/42 PARTITION SECTION
TYP. METAL STUD TYPE
Scale: 1½" = 1'-0"

FSEM

FRANKFURT · SHORT · EMERY · McKINLEY **ARCHITECTS · ENGINEERS**

MEMBER AMERICAN INSTITUTE OF ARCHITECTS


MEMBER AMERICAN SOCIETY OF HEATING, REFRIGERATING AND AIR CONDITIONING ENGINEERS

REVISION	DESCRIPTION	DATE
1	Added Appendix and Addenda Items	1 Mar. 74
2	As Built Conditions	1 Mar. 74
3		
4		
5		
6		


KERR-McGEE CENTER
OKLAHOMA CITY, OKLAHOMA

MISCELLANEOUS DETAILS


COMM. NO. 66624
DATE 29 Sept. 1969
SHEET NO. A-42

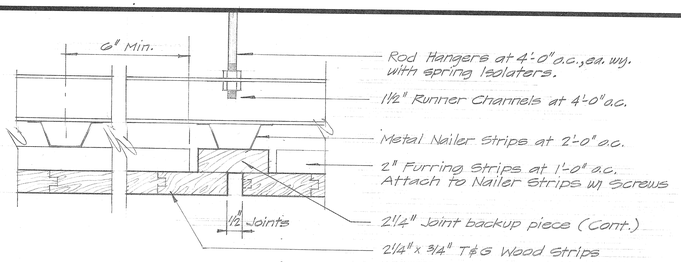


1 / A3/43 DETAIL - WOOD CLG. EXP. JT.
½ Full Size

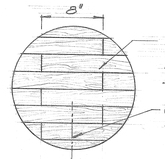


DETAIL - WD. CLG. LAP JT.
Scale: 1½" = 1'-0"

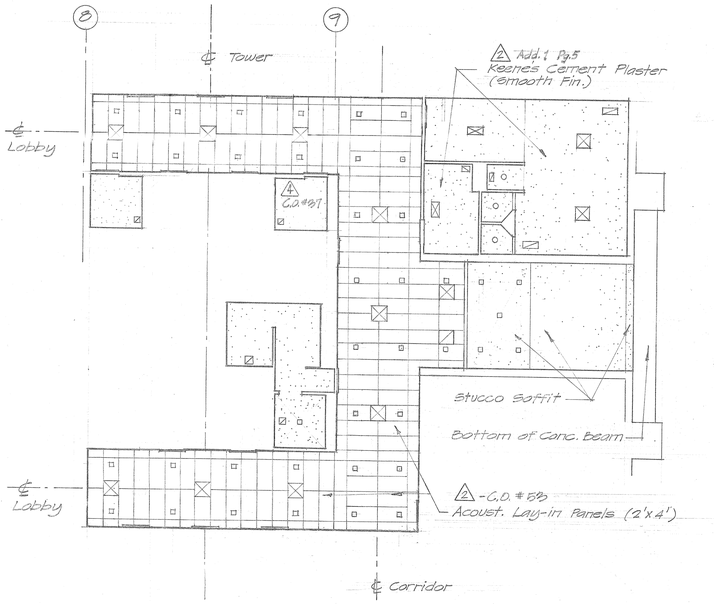

REFLECTED CL'G. PLAN
BASEMENT LOBBY
Scale: 1/8" = 1'-0"

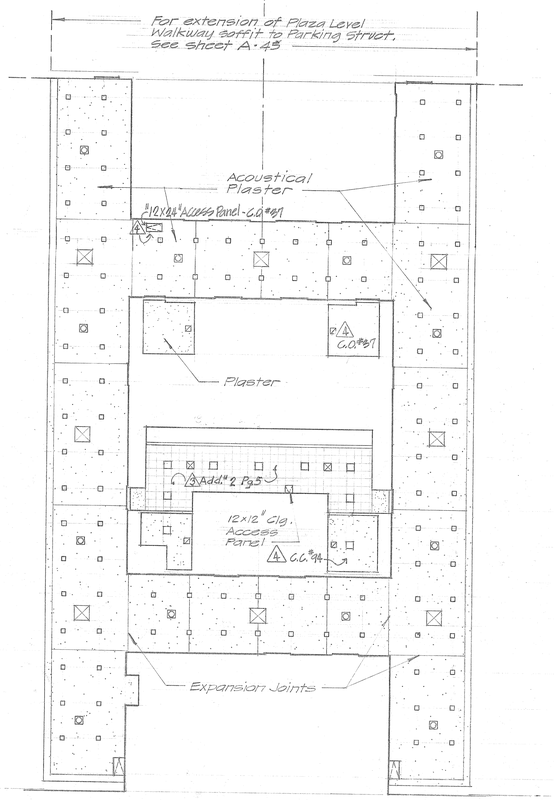

REFLECTED CL'G. PLAN
PLAZA LOBBY UNDER MEZZ.
Scale: 1/8" = 1'-0"

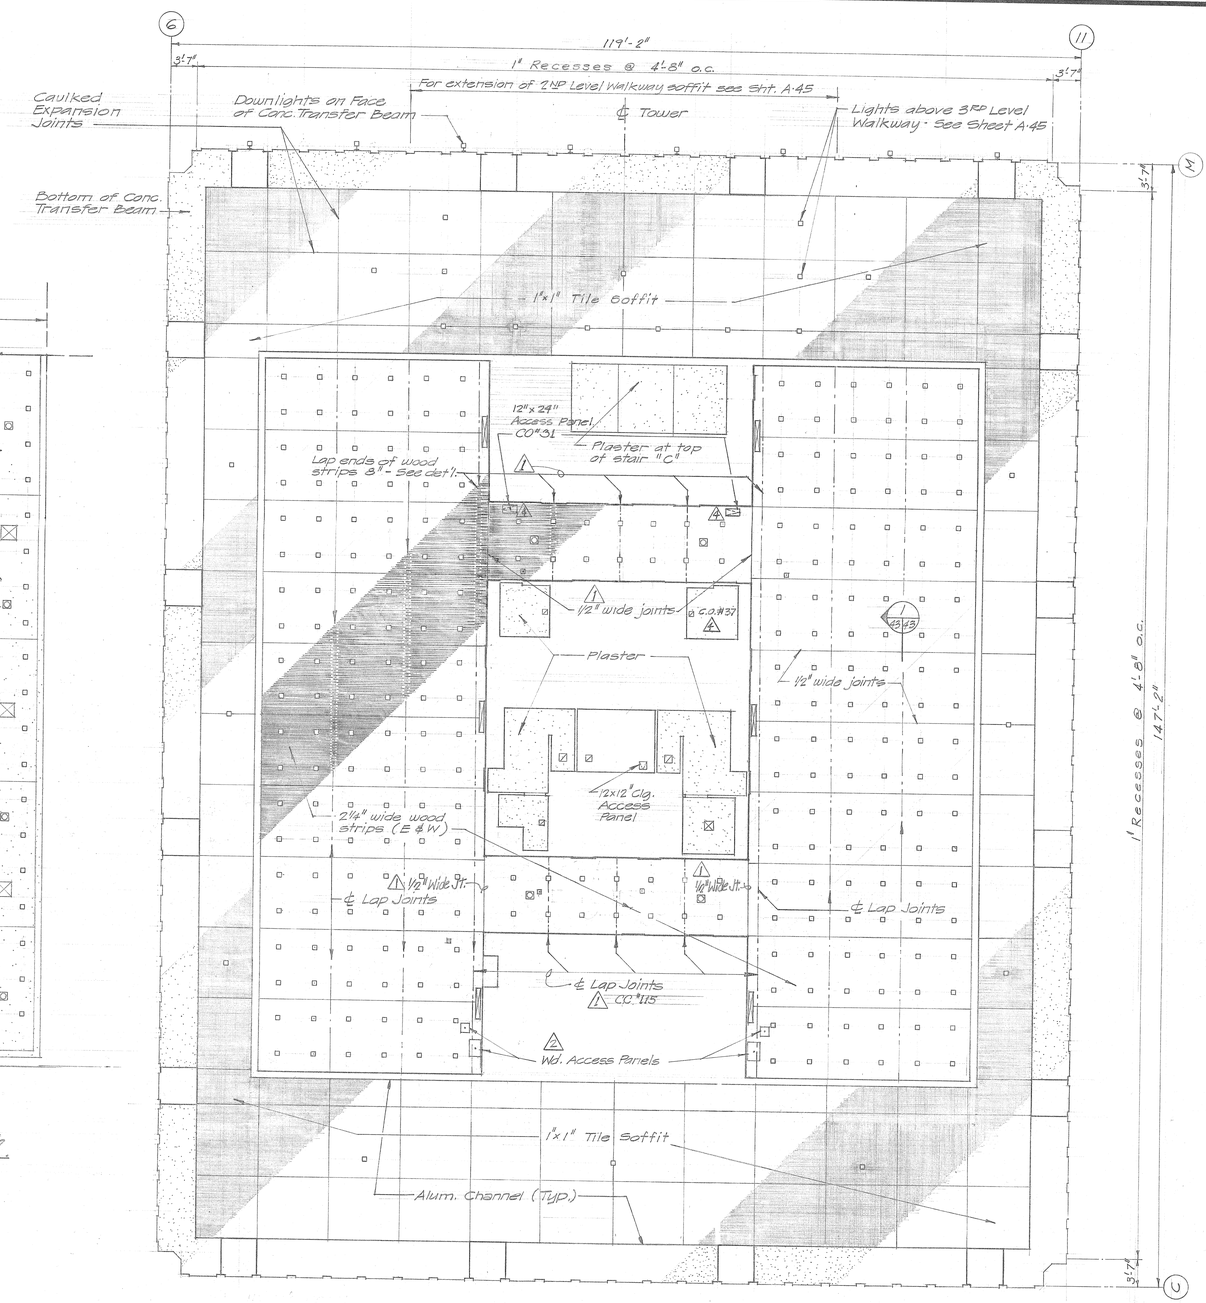

REFLECTED PLAN OF SOFFIT & MEZZANINE CEILING
Scale: 1/8" = 1'-0" Tower Plan

LEGEND
- Light Fixtures
- Air Diffusers
- Speakers
- Exhaust Grilles
- Access Panels
- Removable Wood Strip Access Panel - Flush Mtd. 2

N

FSEM

FRANKFURT · SHORT · EMERY · McKINLEY ARCHITECTS · ENGINEERS

MEMBER AMERICAN INSTITUTE OF ARCHITECTS


MEMBER AMERICAN SOCIETY OF HEATING, REFRIGERATING AND AIR CONDITIONING ENGINEERS

REVISION	DESCRIPTION	DATE
1	Added Wd. Clg. Lap Joints in Elev. Lobbies - Relocated 12" Elev. Panels - Revised Escalator Clg. Plan - Added Wd. Access Panels in Mezz. Clg. - Deleted Stucco Soffit	15 JUNE 72
2	Panels in Mezz. Clg. - Deleted Stucco Soffit	25 JULY 72
3	Added Addenda Items	1 MAY 74
4	As Built Conditions	1 MAY 74
5		
6		

KERR-McGEE CENTER
OKLAHOMA CITY, OKLAHOMA


COMM. NO. 3G624
DATE 29 Sept 1969
SHEET NO. A-43

REFLECTED CEILING PLANS - BASEMENT, MEZZANINE, LOBBY, TOWER SOFFIT, MISC. DETAILS

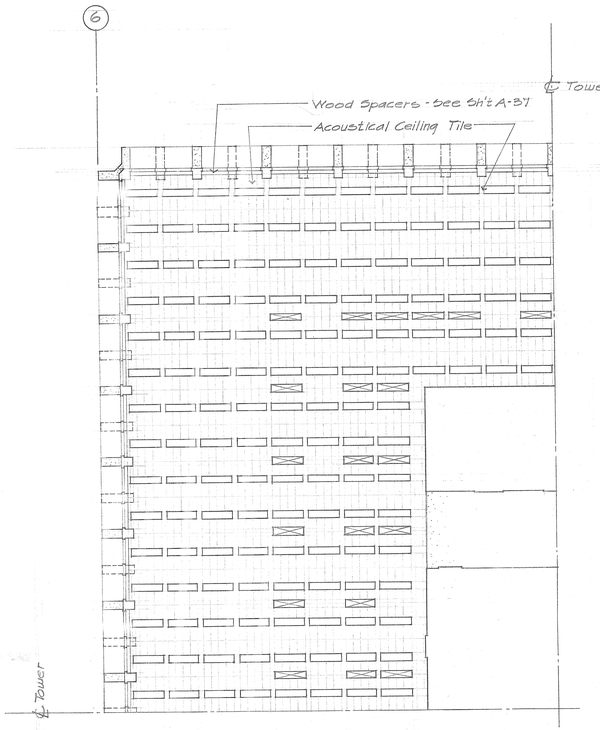


ALTERNATE CEILING PATTERN

Scale: 1/8" = 1'-0" ⚠4 (Not Used)

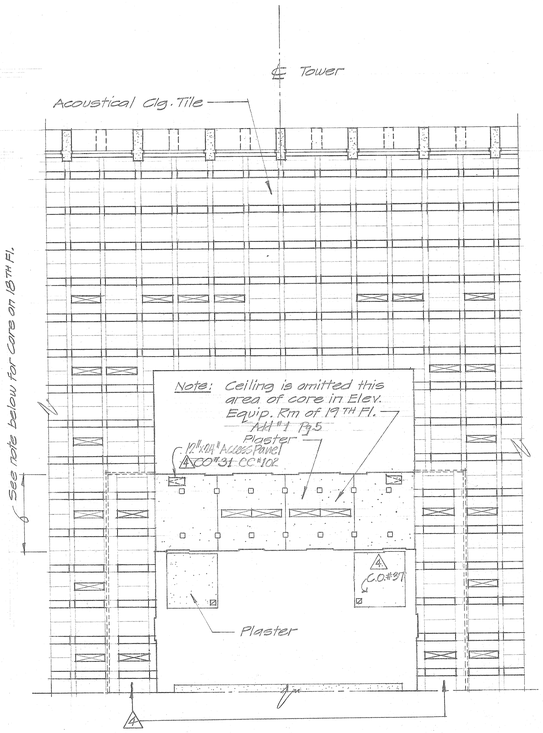


PARTIAL REFLECTED CLG. PLAN - FLOORS 4-19

Scale: 1/8" = 1'-0" Showing North Elevator Lobby (18th North Elev. Lobby Below) Portions not drawn are identical to adjacent plan.

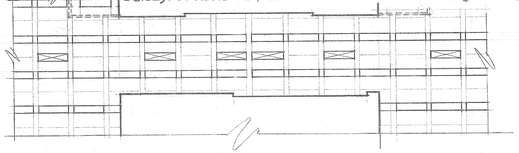


REFLECTED CLG. - SOUTH ELEVATOR CORRIDOR - FLOORS 4-16

Scale: 1/8" = 1'-0" Identical for North Elev. Corridor on 18TH Floor

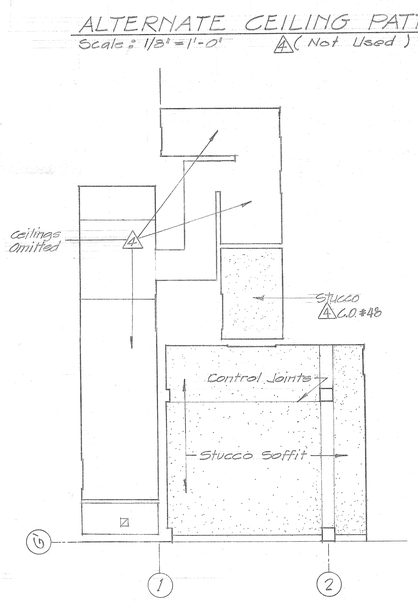


REFLECTED CEILGS. AT SERVICE DOCK AND CORRIDORS AT O.M.B.

Scale: 1/8" = 1'-0"

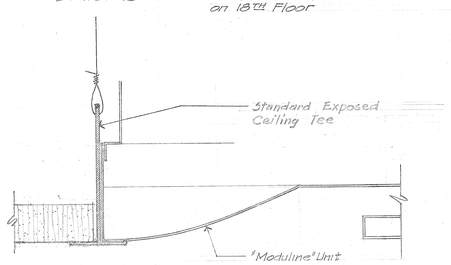

MODULINE UNIT SUPPORT @ ACOUST. CEILING TILE

Scale: Full Size

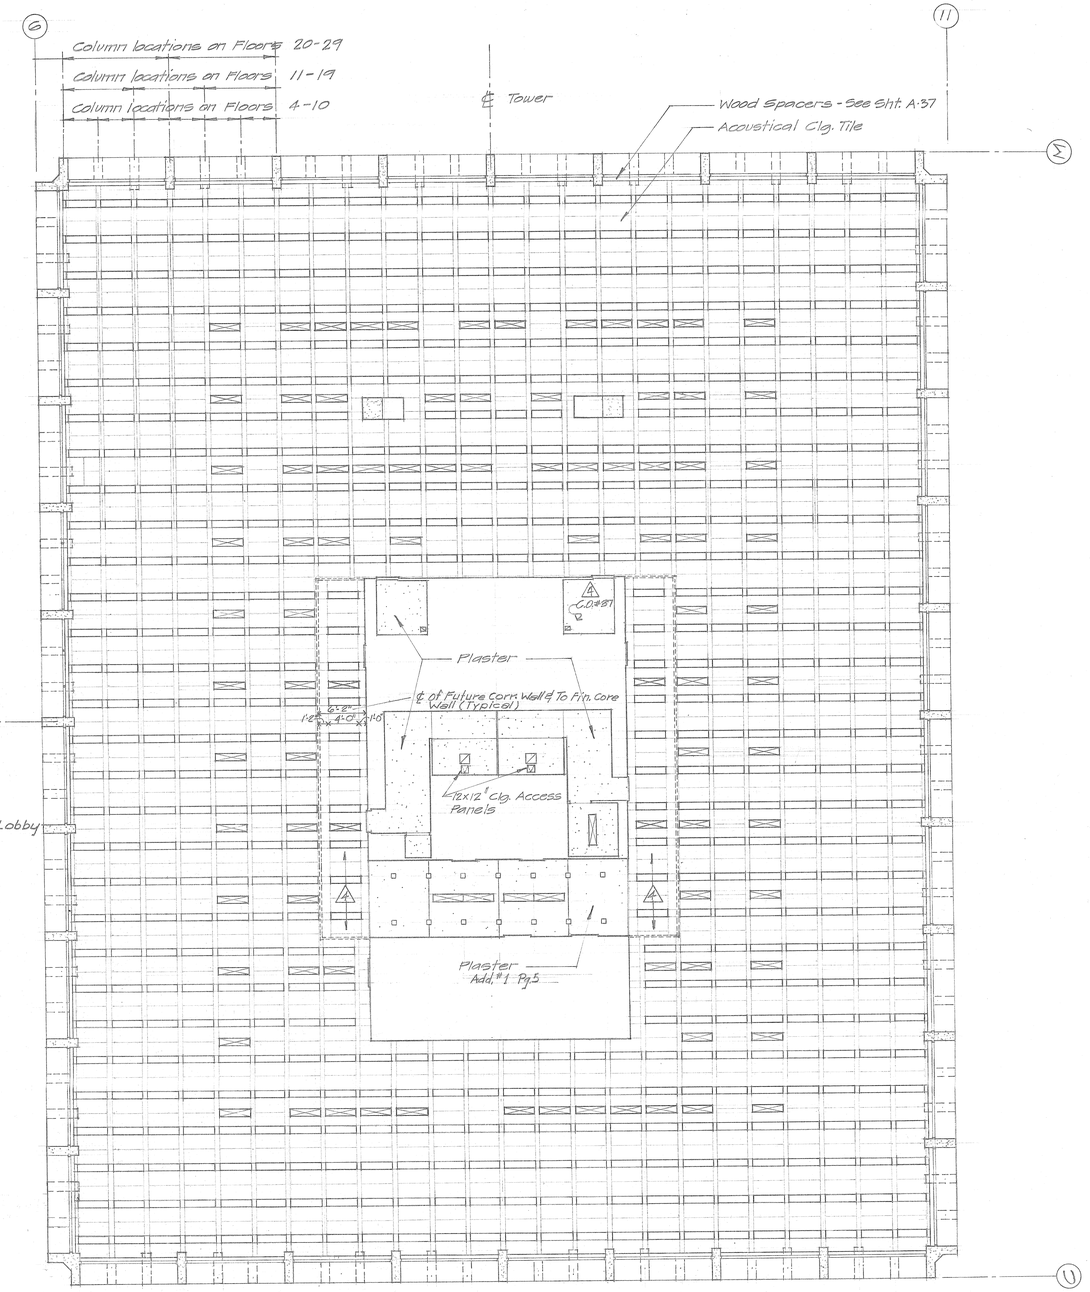

TYPICAL REFLECTED CEILING PLAN - TOWER FLOORS 20 thru 27

Scale: 1/8" = 1'-0" Similar for Floors 4 thru 19 except as shown on adjacent plan. South Lobby Correct for 17, 18 & 19

LEGEND: Light Fixtures; Air Diffusers; Speakers (To be located as rooms are determined.); Speakers

N

VOID

REVISION	DESCRIPTION	DATE
1	Appendix Item 37	Feb 2, 78
2	Center Lights In Corridor	Feb 20, 78
3	Added Appendix & Addenda Items	1 Mar 74
4	As Built Conditions	1 Mar 74
5		
6		

FSEM

FRANKFURT · SHORT · EMERY · McKINLEY ARCHITECTS · ENGINEERS


MEMBER AMERICAN INSTITUTE OF ARCHITECTS

MEMBER AMERICAN SOCIETY OF HEATING, REFRIGERATING AND AIR CONDITIONING ENGINEERS

KERR-McGEE CENTER
OKLAHOMA CITY OKLAHOMA


REFLECTED CEILING PLAN TYPICAL TOWER FLOOR

COMM. NO. 3606.24
DATE 29 Sept. 1969
SHEET NO. A-44

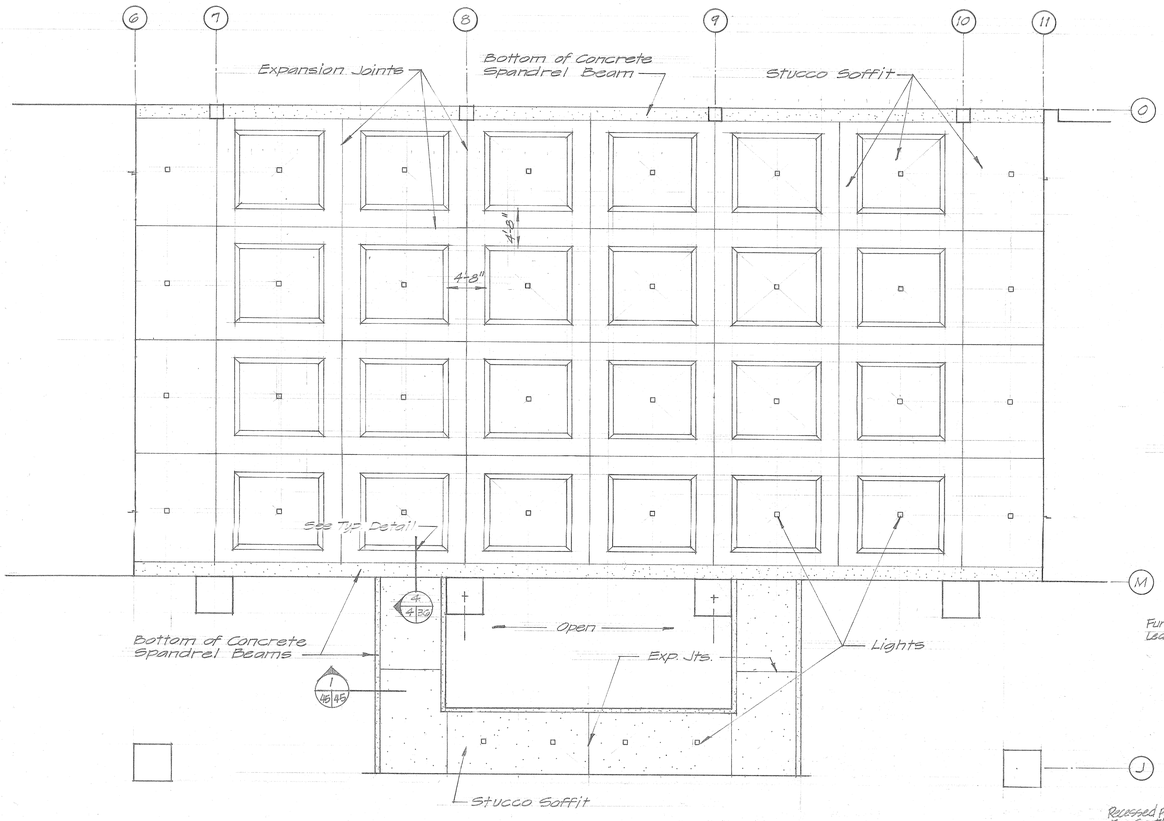

REFLECTED CEILING PLAN ABOVE EXTERIOR PLAZA AT THIRD STREET

Scale : 1/8" = 1'-0"

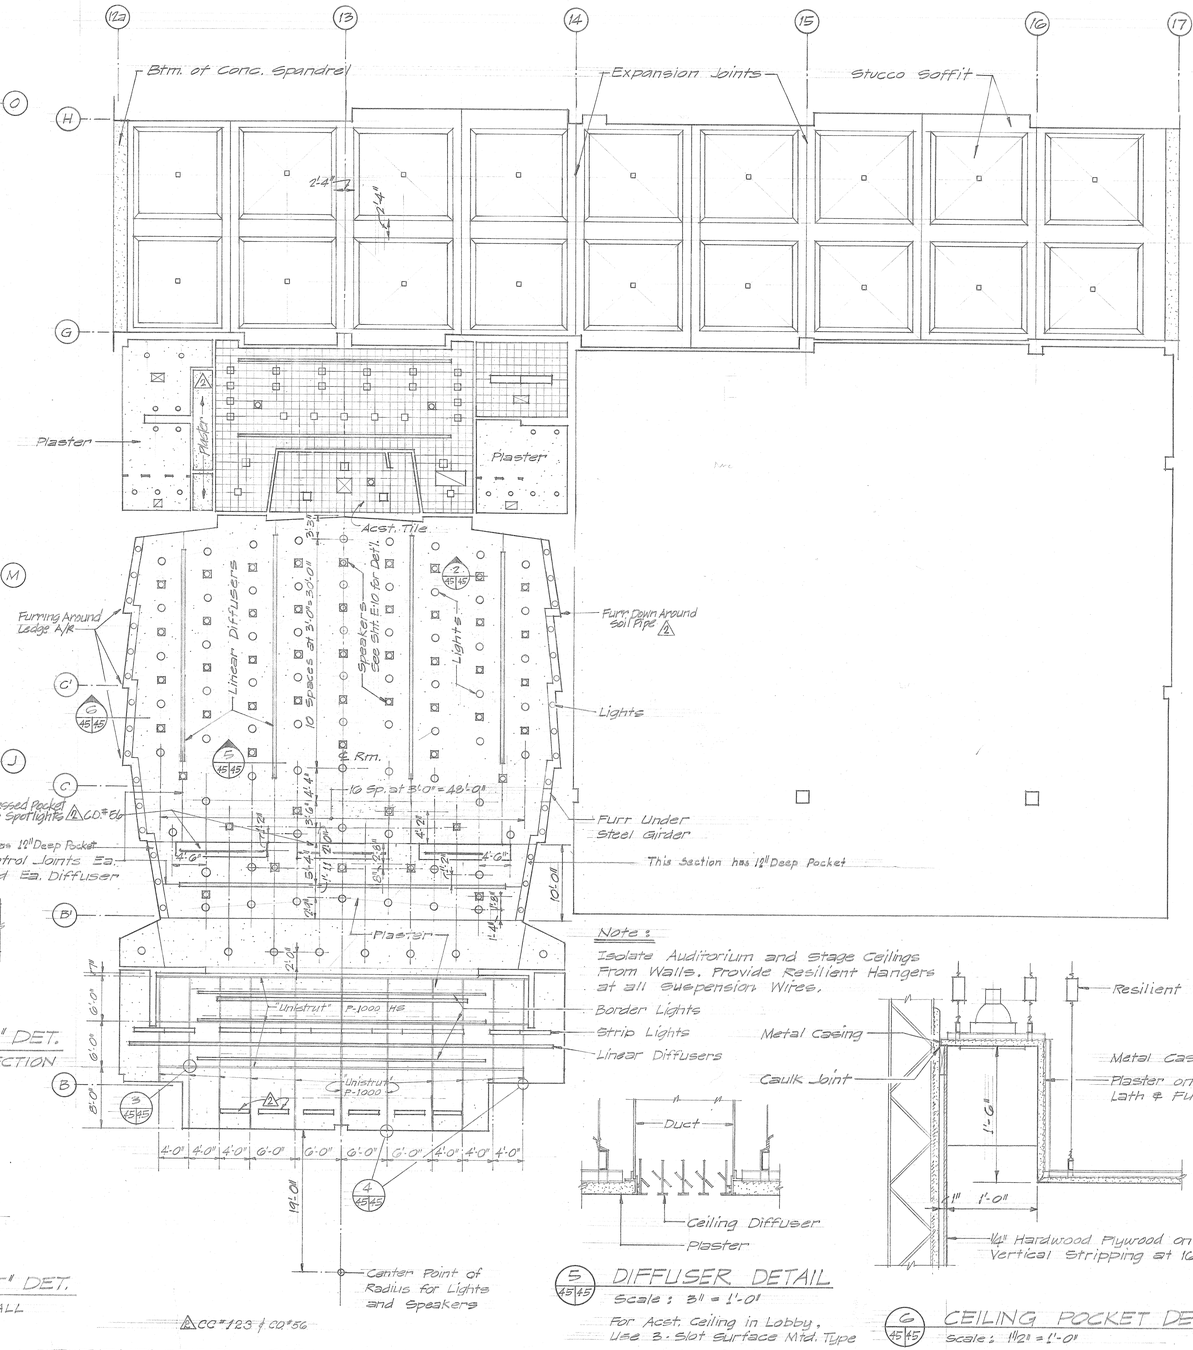


CC = 123 ℄ CC = 56

REFLECTED CEILING PLAN OF AUDITORIUM, EAST CONCOURSE, AND SHOP AREA "C"


Scale : 1/8" = 1'-0"

Note :
Isolate Auditorium and Stage Ceilings From Walls. Provide Resilient Hangers at all Suspension Wires.

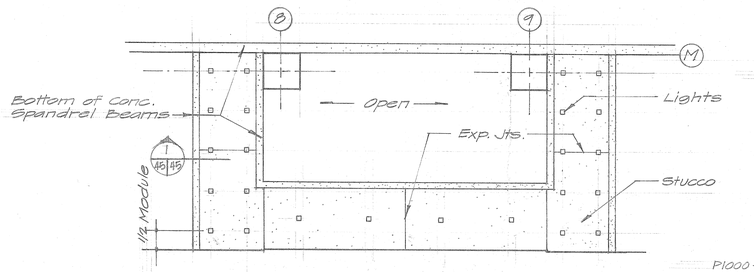


REFLECTED CEILING PLAN ABOVE 2ND FLOOR (MEZZ.) WALKWAY


Scale: 1/8" = 1'-0" See Tower Soffit Plan for Light Pattern above 3RD Level Walkway

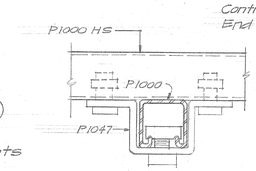


3 "UNISTRUT" DET.
TYP. INTERSECTION
1/2 P.S.

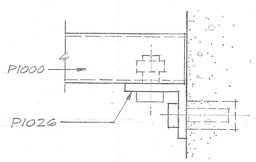

4 "UNISTRUT" DET.
MASONRY WALL
1/2 P.S.

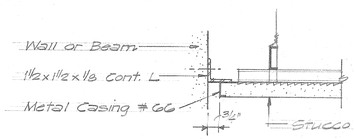


1 SOFFIT DETAIL
TYPICAL EDGE
Scale : 3" = 1'-0"

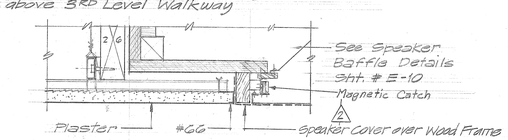

2 TYP. SPEAKER FRAME
AUDITORIUM RM. # P-35
Scale : 3" = 1'-0"

5 DIFFUSER DETAIL
Scale : 3" = 1'-0"
For Acst. Ceiling in Lobby, Use 3-Slot Surface Mtd. Type

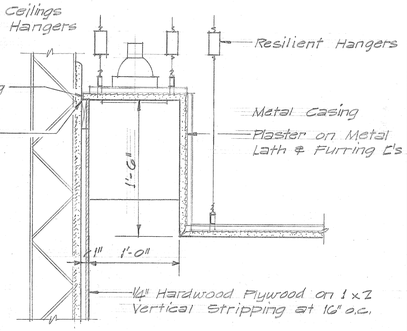

6 CEILING POCKET DETAIL
Scale : 1 1/2" = 1'-0"

N

FSEM

FRANKFURT · SHORT · EMERY · McKINLEY ARCHITECTS · ENGINEERS

MEMBER AMERICAN INSTITUTE OF ARCHITECTS


MEMBER AMERICAN SOCIETY OF HEATING, REFRIGERATING AND AIR CONDITIONING ENGINEERS

REVISION	DESCRIPTION	DATE
1	Added Addenda Items	1 Mar. 74
2	As Built Conditions	1 Mar. 74
3		
4		
5		
6		


KERR-McGEE CENTER
OKLAHOMA CITY, OKLAHOMA

REFLECTED CEILING PLAN AUDITORIUM


COMM. NO. 3666.24
DATE 29 Sept 1969
SHEET NO. A-45

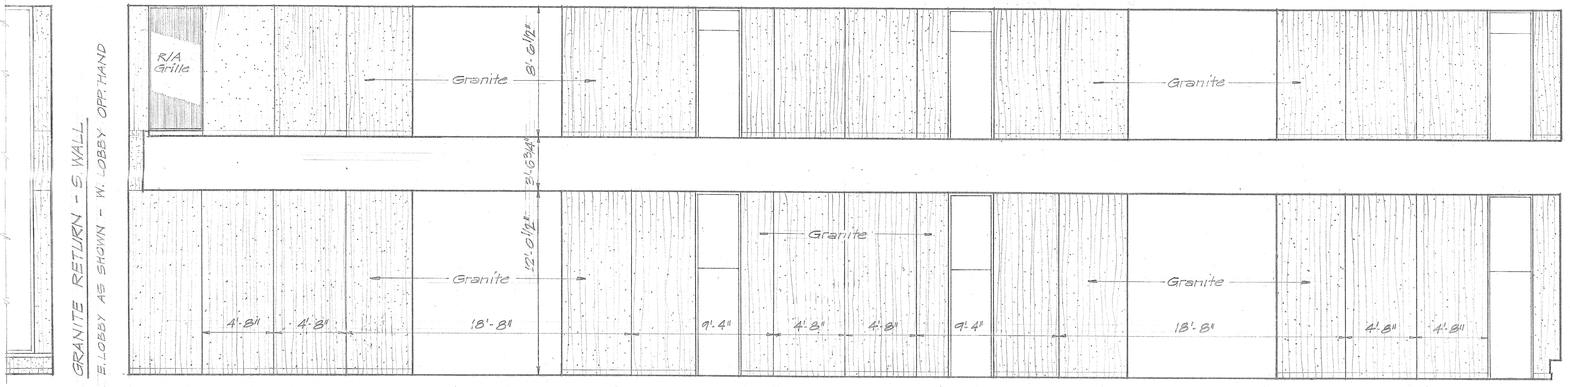


WEST WALL - EAST LOBBY RM. # P-25

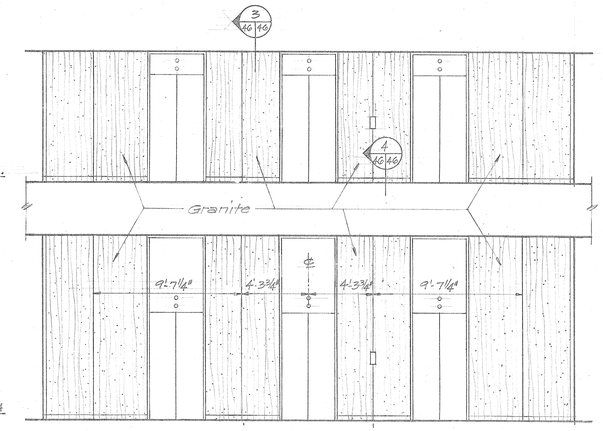


N. WALL - ELEVATOR LOBBY RMS. #204 & P-18

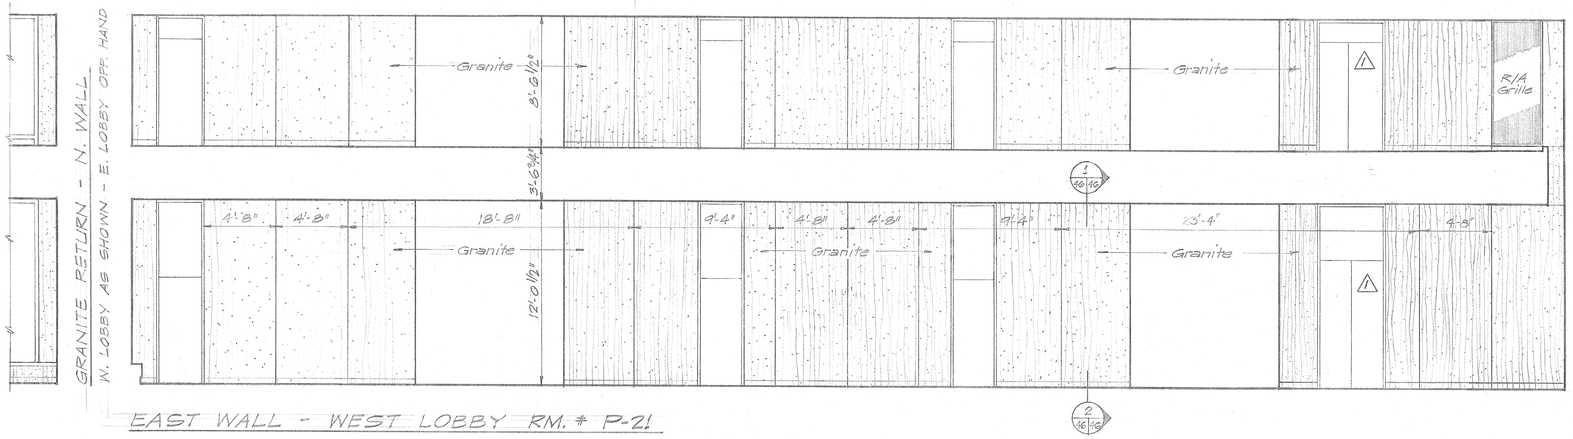


EAST WALL - WEST LOBBY RM. # P-21

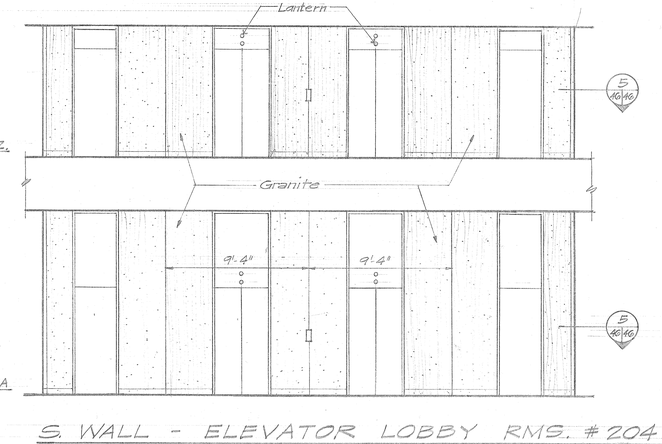

S. WALL - ELEVATOR LOBBY RMS. #204 & P-18

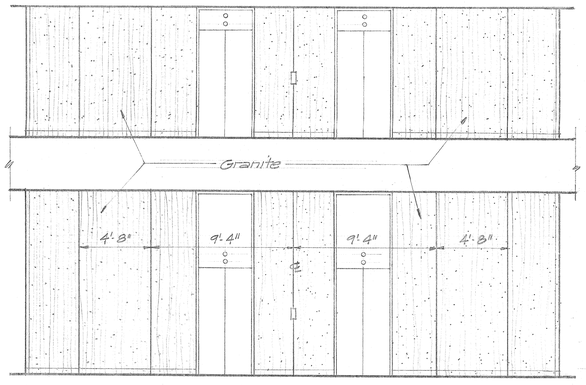


N. WALL - ELEVATOR LOBBY RMS. #214 & P-26

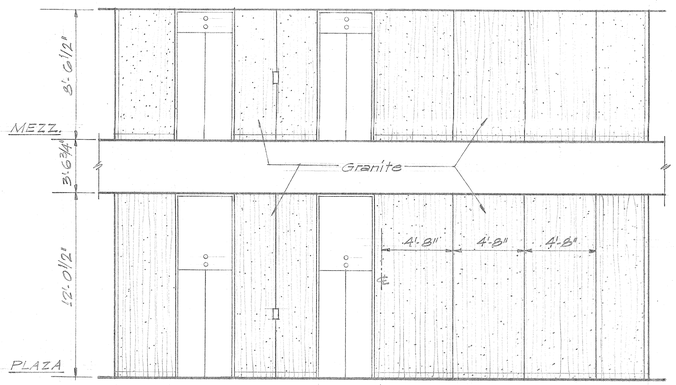

S. WALL - ELEVATOR LOBBY RMS. #214 & P-26

INTERIOR WALL ELEVATIONS - PLAZA AND MEZZANINE FLOORS

Scale : 1/4" = 1'-0"

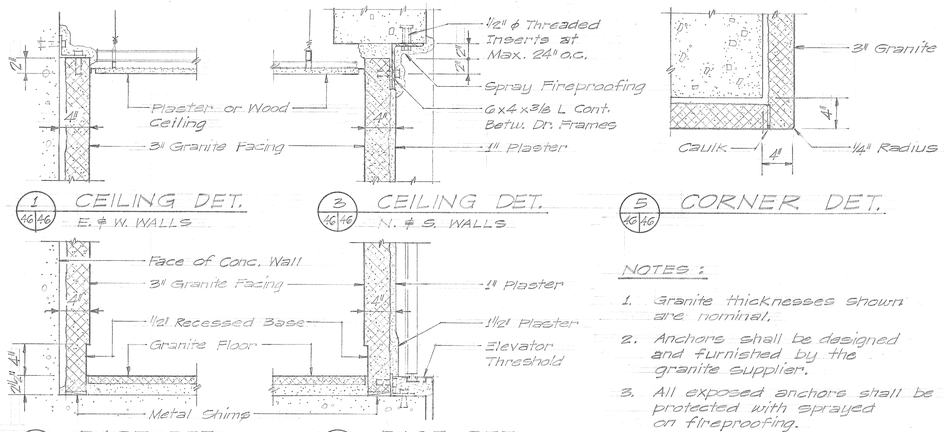

NOTES :

1. Granite thicknesses shown are nominal.
2. Anchors shall be designed and furnished by the granite supplier.
3. All exposed anchors shall be protected with sprayed on fireproofing.
4. Joints between wall panels shall be 1/4" wide, and caulked as specified.

GRANITE WALL DETAILS

Scale : 1 1/2" = 1'-0"

FSEM

FRANKFURT · SHORT · EMERY · McKINLEY **ARCHITECTS · ENGINEERS**

MEMBER AMERICAN INSTITUTE OF ARCHITECTS

MEMBER AMERICAN SOCIETY OF HEATING, REFRIGERATING AND AIR CONDITIONING ENGINEERS

REVISION	DESCRIPTION	DATE
1	AS BUILT CONDITIONS	1 Mar. 74
2		
3		
4		
5		
6		

KERR-McGEE CENTER
OKLAHOMA CITY OKLAHOMA

INTERIOR ELEVATIONS TOWER LOBBY AND MEZZANINE

CONTR. NO. 2666/24

DATE 29 Sept 1969

SHEET NO. A-46